


9+943.48  
DRIVE RT.

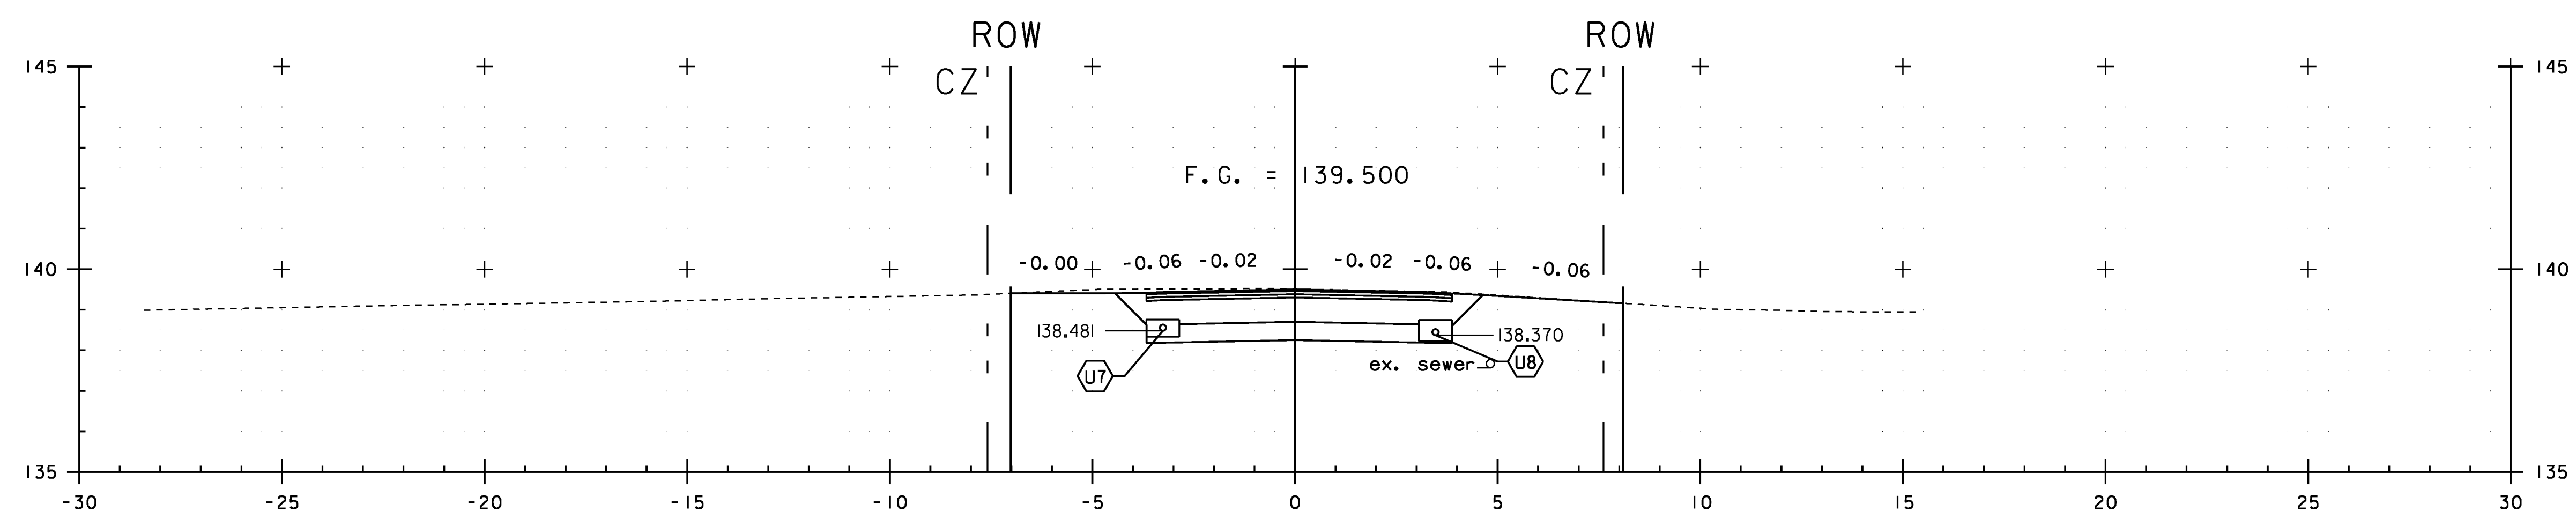

9+940.00

VT ROUTE 108

STA. 9+940 TO STA. 9+943

PROJECT NAME:	CAMBRIDGE
PROJECT NUMBER:	STP 030-2(27)
FILE NAME:	+78f163xsl.dgn
PROJECT LEADER:	JLS
DESIGNED BY:	MBL
CROSS SECTION SHEET 30	
PLOT DATE:	05-JUN-2012
DRAWN BY:	MBL
CHECKED BY:	JAD
SHEET	III OF 214