


9+970.00

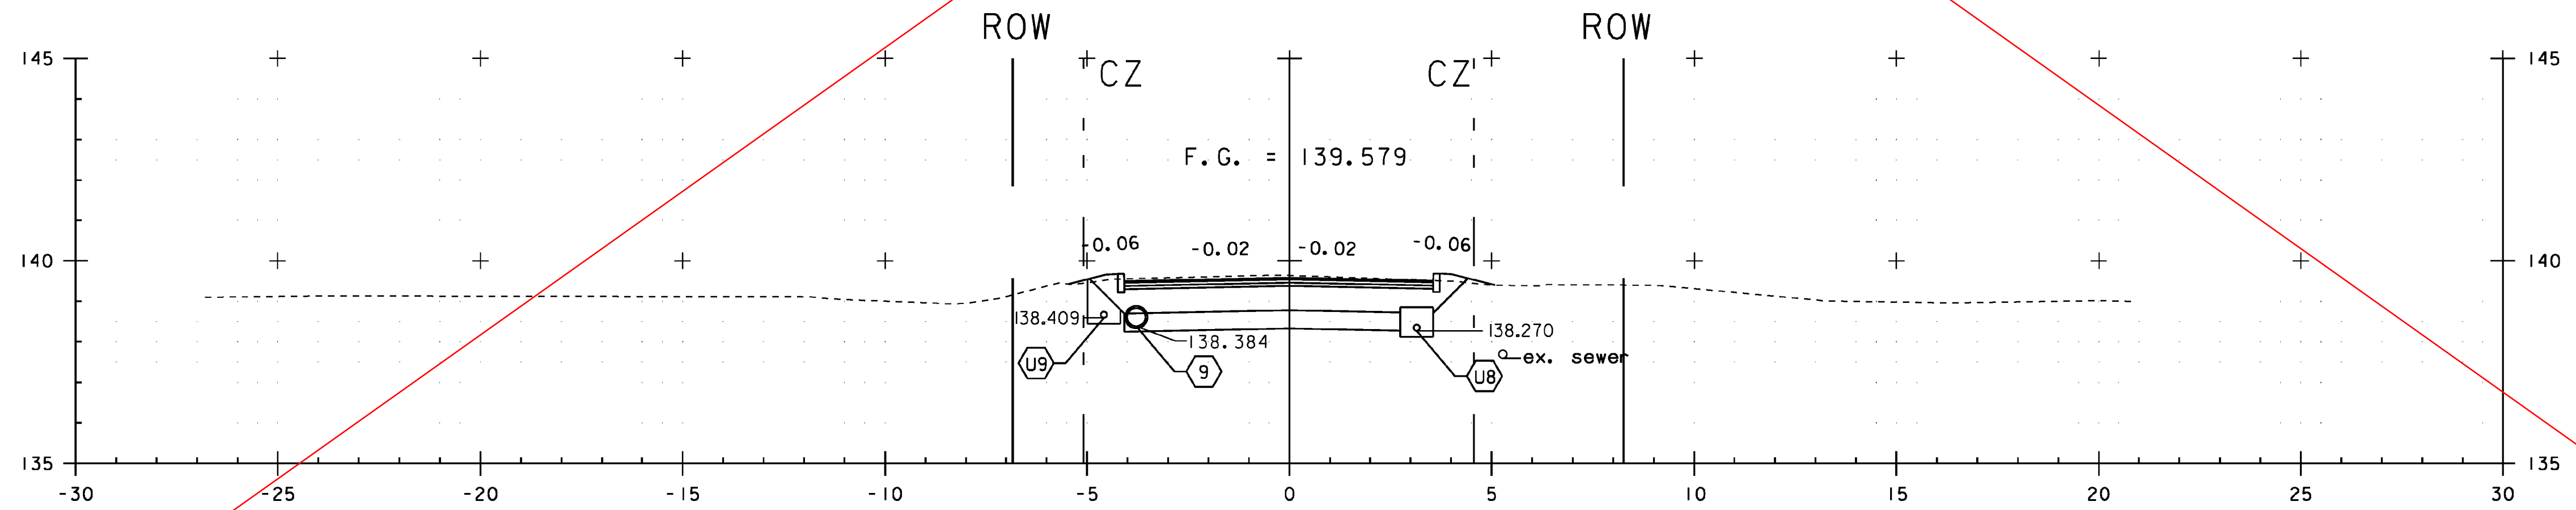

9+960.00

VT ROUTE 108

STA. 9+960 TO STA. 9+970

PROJECT NAME:	CAMBRIDGE	PLOT DATE:	05 JUN-2012
PROJECT NUMBER:	STP 030-2(27)	DRAWN BY:	MBL
FILE NAME:	+78f163xsl.dgn	CHECKED BY:	JAD
PROJECT LEADER:	JLS	SHEET	113 OF 214
DESIGNED BY:	MBL	CROSS SECTION SHEET	32

SEE REVISION SHEET