



9+970.00

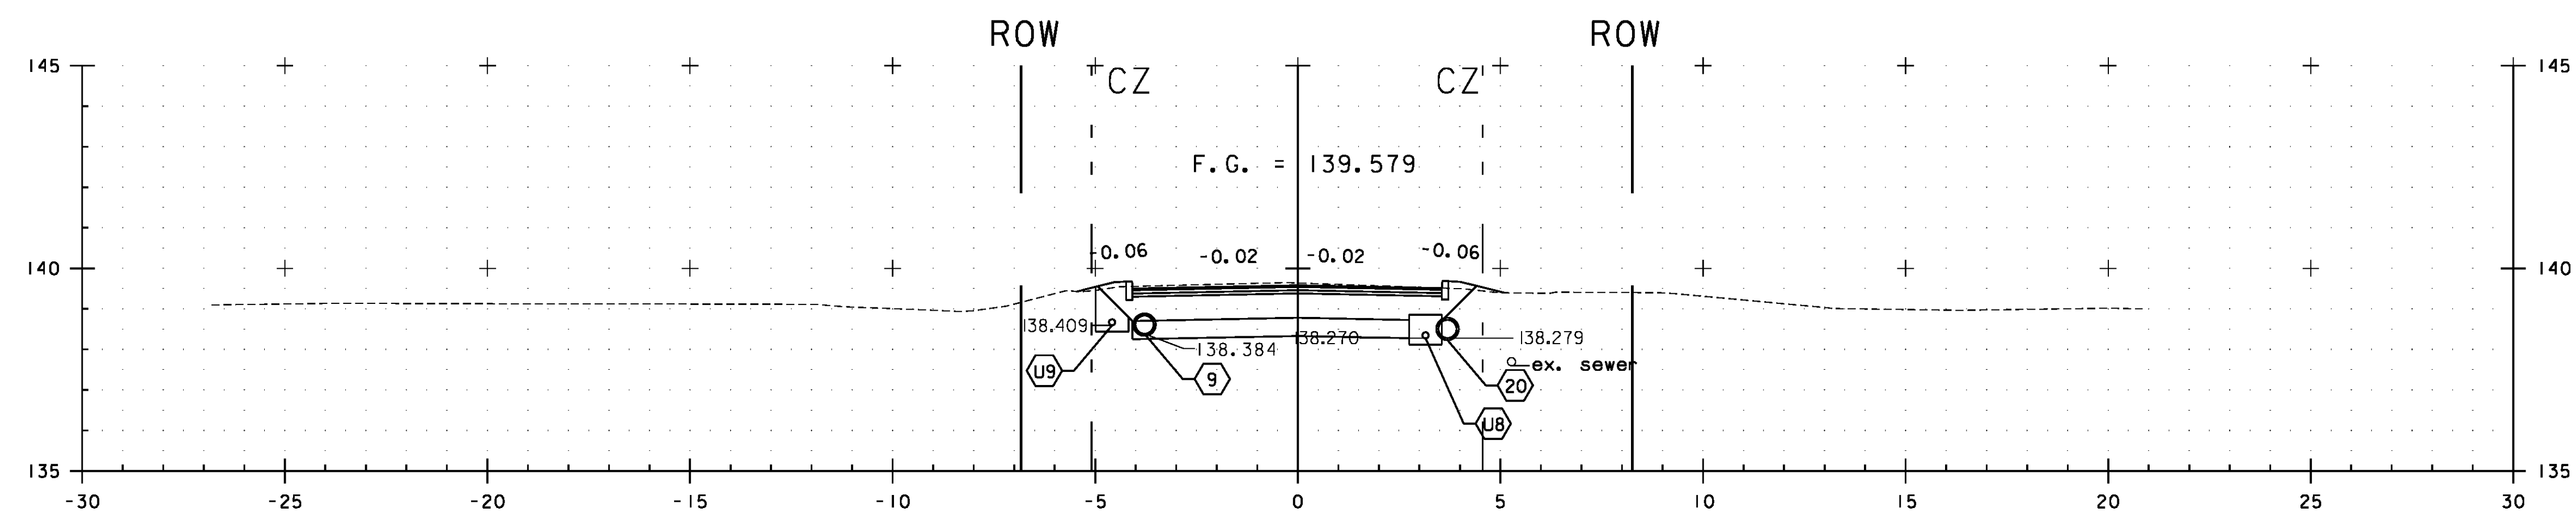

9+960.00

VT ROUTE 108

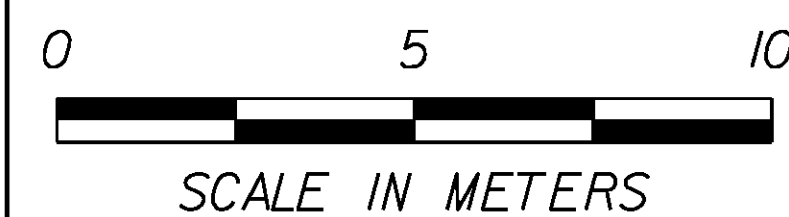

REVISED 9+970 FINISH GRADE AND SUBGRADE STA. 9+960 TO STA. 9+970

PROJECT NAME: CAMBRIDGE
 PROJECT NUMBER: STP 030-2(27)

FILE NAME: f78f163xsl.dgn PLOT DATE: 4/22/13
 PROJECT LEADER: JLS DRAWN BY: MBL
 DESIGNED BY: MBL CHECKED BY: JAD
 CROSS SECTION SHEET 32 - REVISED SHEET 13 OF 214