



9+980.00

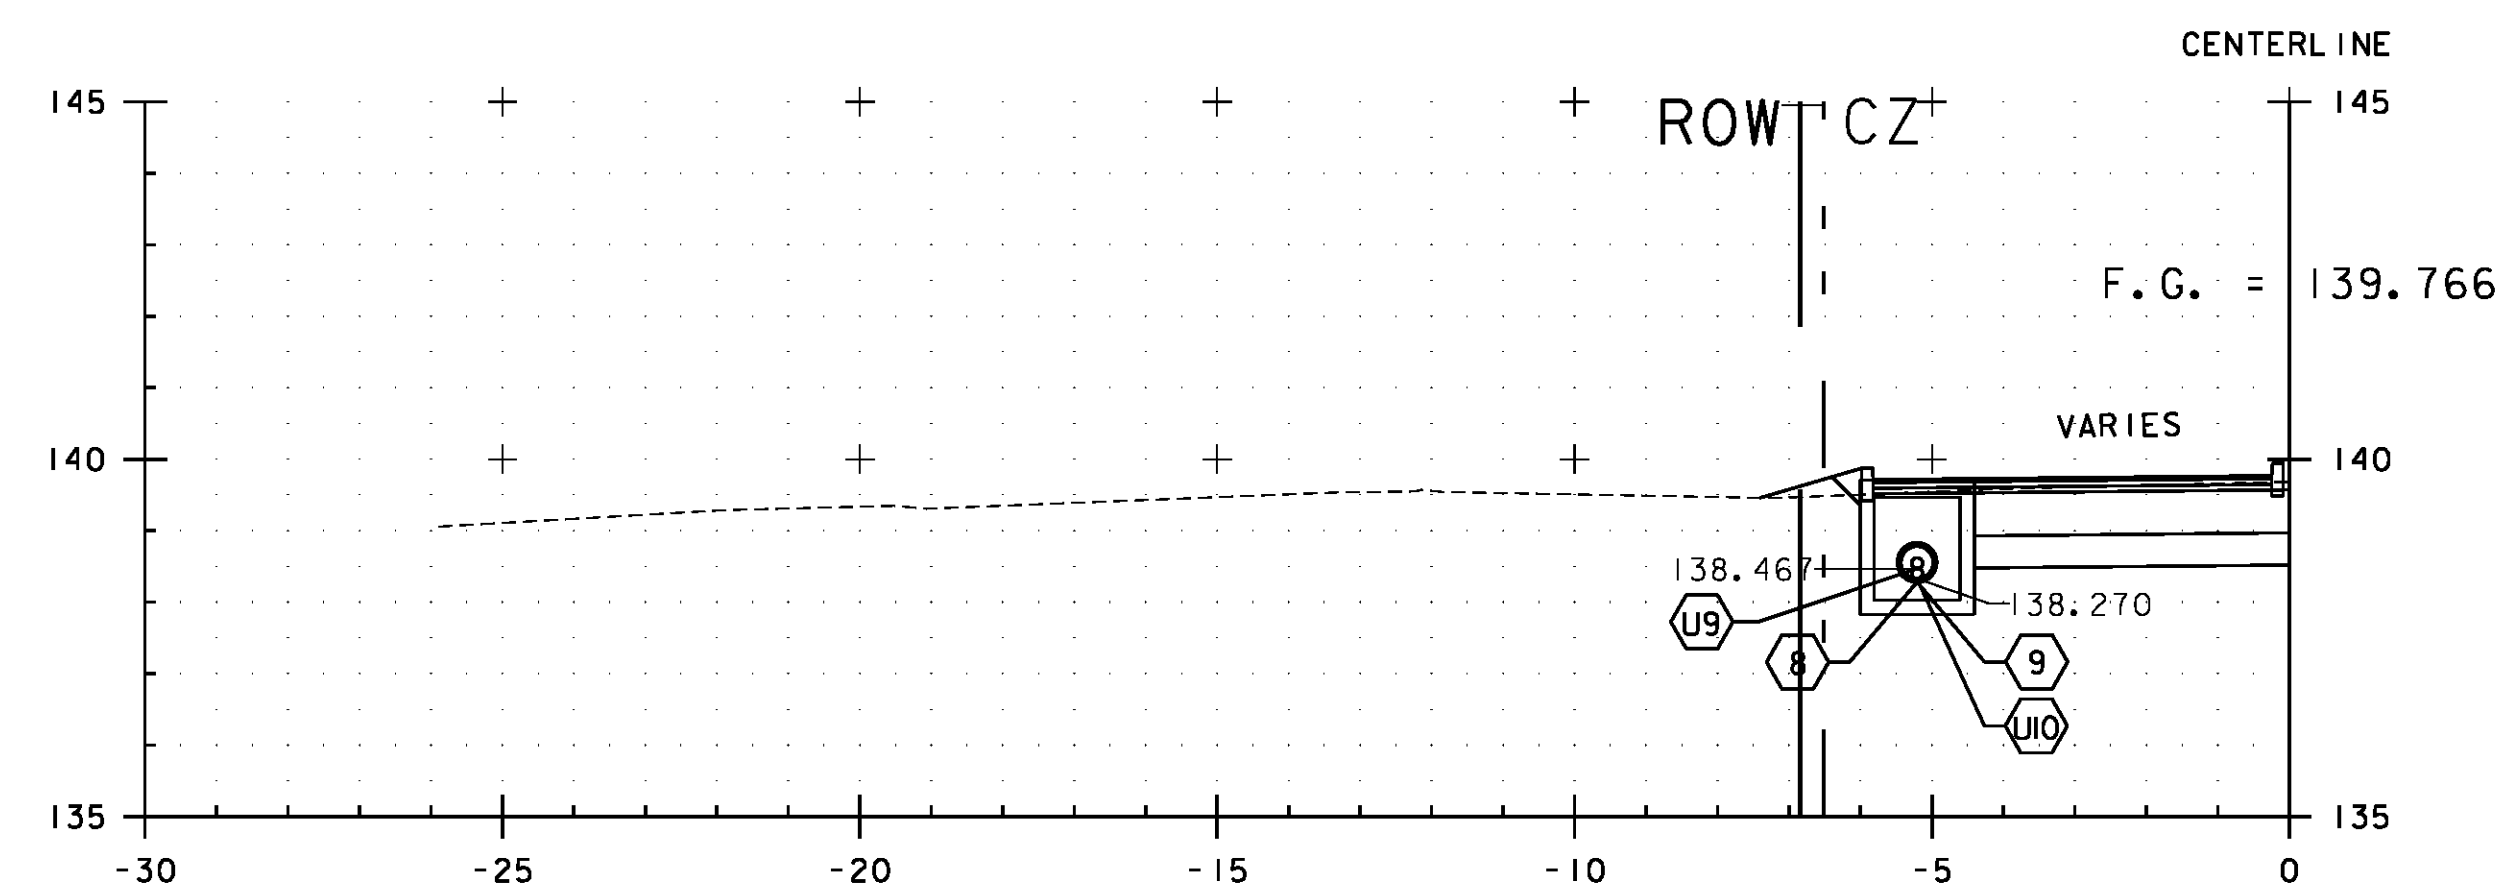

9+971.69

VT ROUTE 108

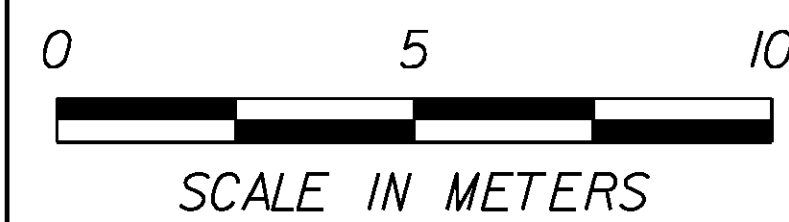

- REVISED 9+980 FINISH GRADE AND SUBGRADE
- REVISED REVISED FINISH GRADE, SUBGRADE, AND RIM ELEVATION

STA. 9+972 TO STA. 9+980

PROJECT NAME: CAMBRIDGE
PROJECT NUMBER: STP 030-2(27)

FILE NAME: f78f163xsl.dgn	PLOT DATE: 4/22/13
PROJECT LEADER: JLS	DRAWN BY: MBL
DESIGNED BY: MBL	CHECKED BY: JAD
CROSS SECTION SHEET 33 - REVISED	SHEET 114 OF 214