


9+984.53

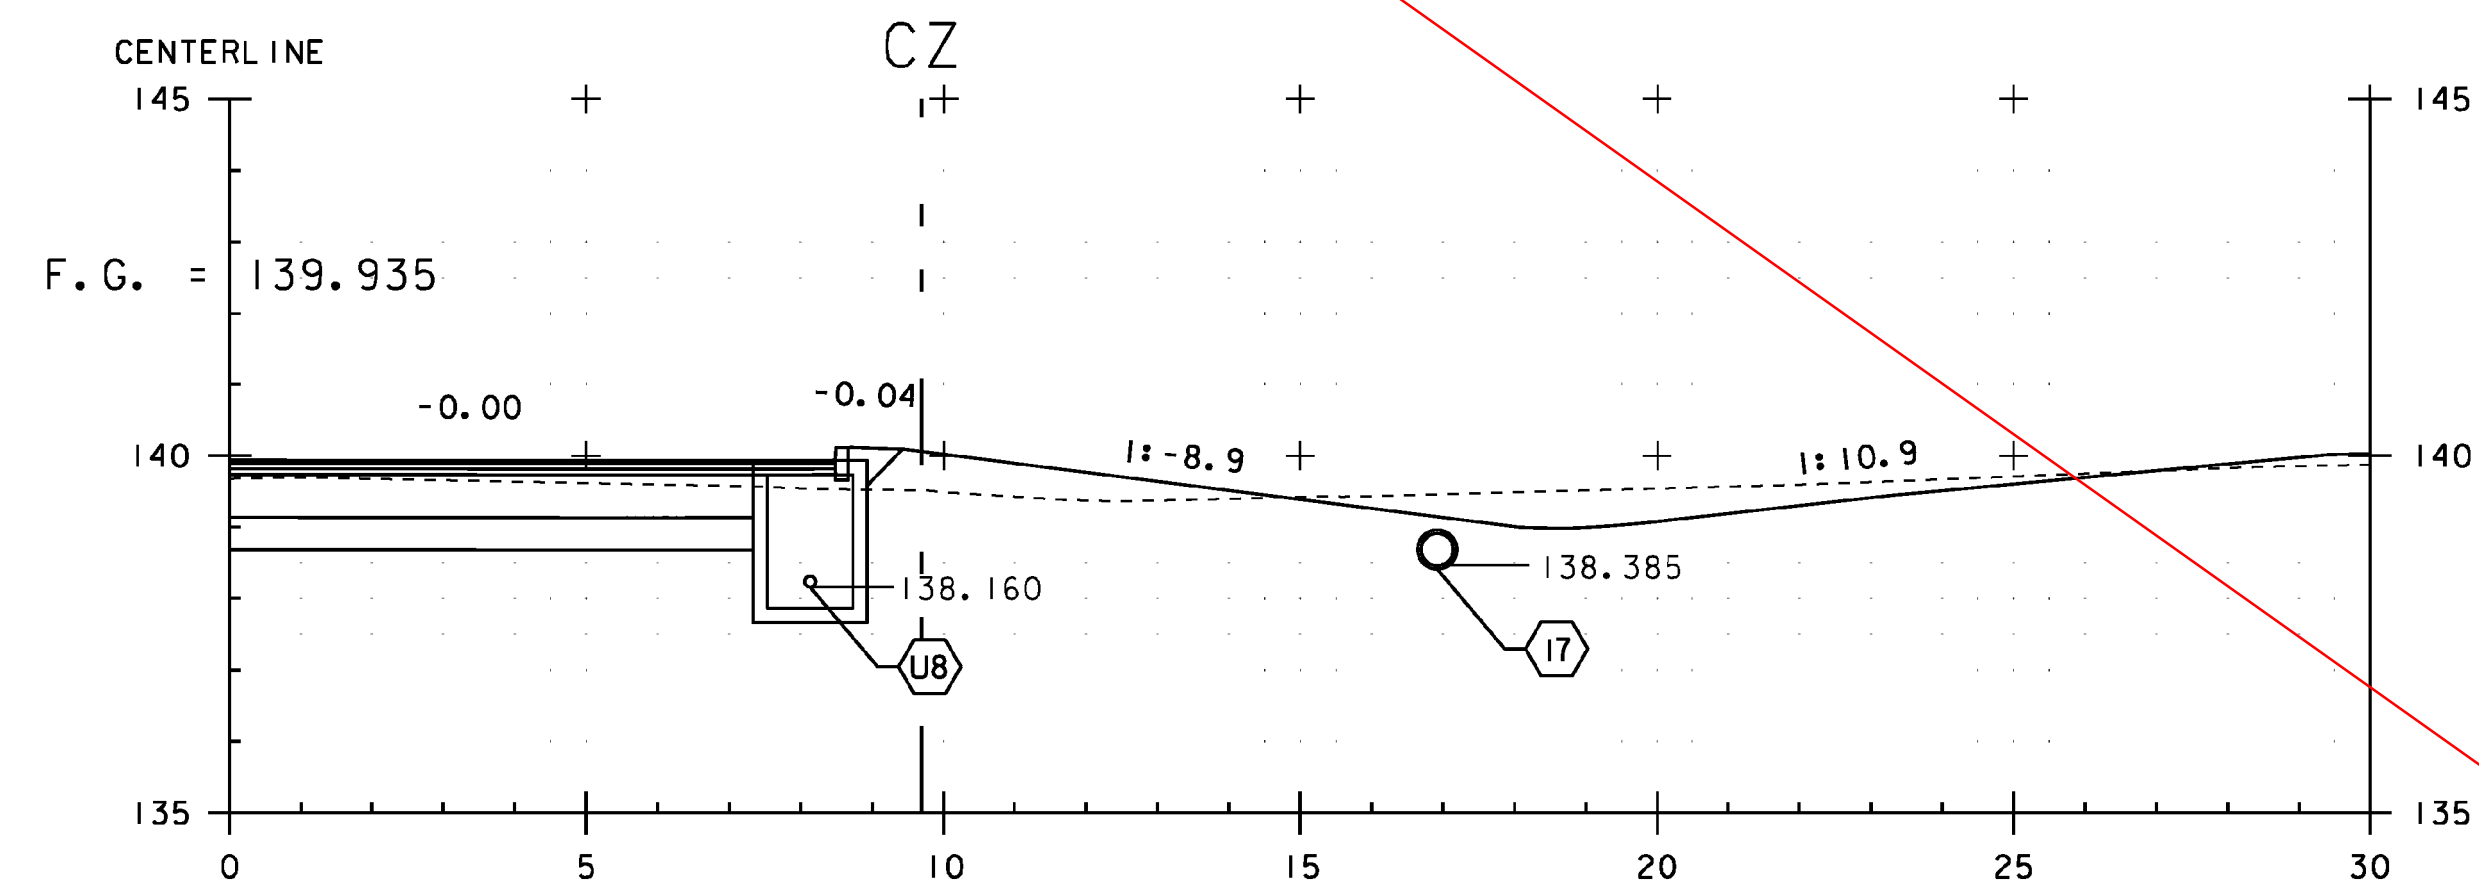

9+982.00

VT ROUTE 108

STA. 9+982 TO STA. 9+985

PROJECT NAME: CAMBRIDGE	PLOT DATE: 05 JUN-2012
PROJECT NUMBER: STP 030-2(27)	DRAWN BY: MBL
FILE NAME: +78f163xsl.dgn	CHECKED BY: JAD
PROJECT LEADER: JLS	SHEET 115 OF 214
DESIGNED BY: MBL	
CROSS SECTION SHEET 34	

SEE REVISION SHEET