


VT ROUTE 108

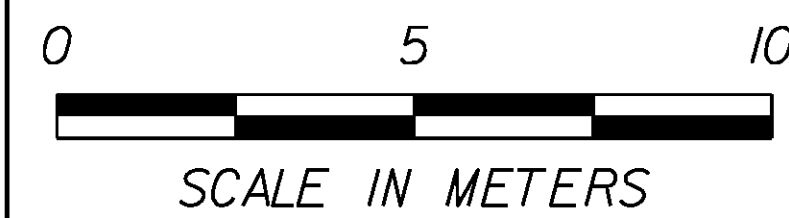

- \triangle 1 REVISED 9+983.92 FINISH GRADE, SUBGRADE AND RIM ELEVATION
- \triangle 2 REVISED 9+982 FINISH GRADE AND SUBGRADE

STA. 9+982 TO STA. 9+985

PROJECT NAME: CAMBRIDGE
PROJECT NUMBER: STP 030-2(27)

FILE NAME: f78f163xsl.dgn
PROJECT LEADER: JLS
DESIGNED BY: MBL
CROSS SECTION SHEET 34

PLOT DATE: ****DATE***
DRAWN BY: MBL
CHECKED BY: JAD
SHEET 55 OF 57