


10+000.00

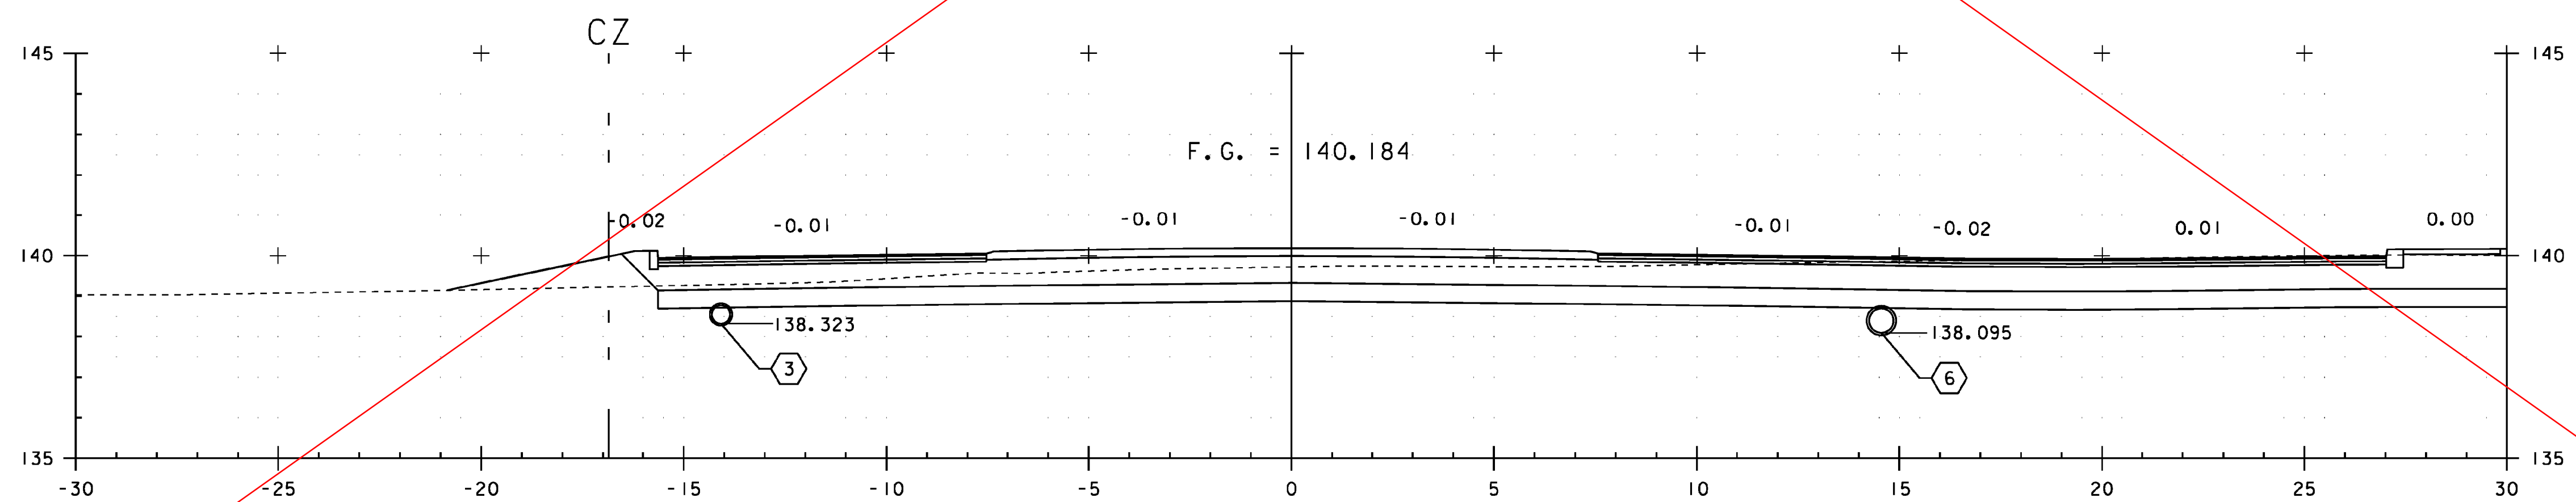

9+990.00

VT ROUTE 108

STA. 9+990 TO STA. 10+000

PROJECT NAME: CAMBRIDGE  
PROJECT NUMBER: STP 030-2(27)

FILE NAME: +78f163xsl.dgn  
PROJECT LEADER: JLS  
DESIGNED BY: MBL  
CROSS SECTION SHEET 35

PLOT DATE: 05 JUN-2012  
DRAWN BY: MBL  
CHECKED BY: JAD  
SHEET 116 OF 214

SEE REVISION SHEET