


10+018.14

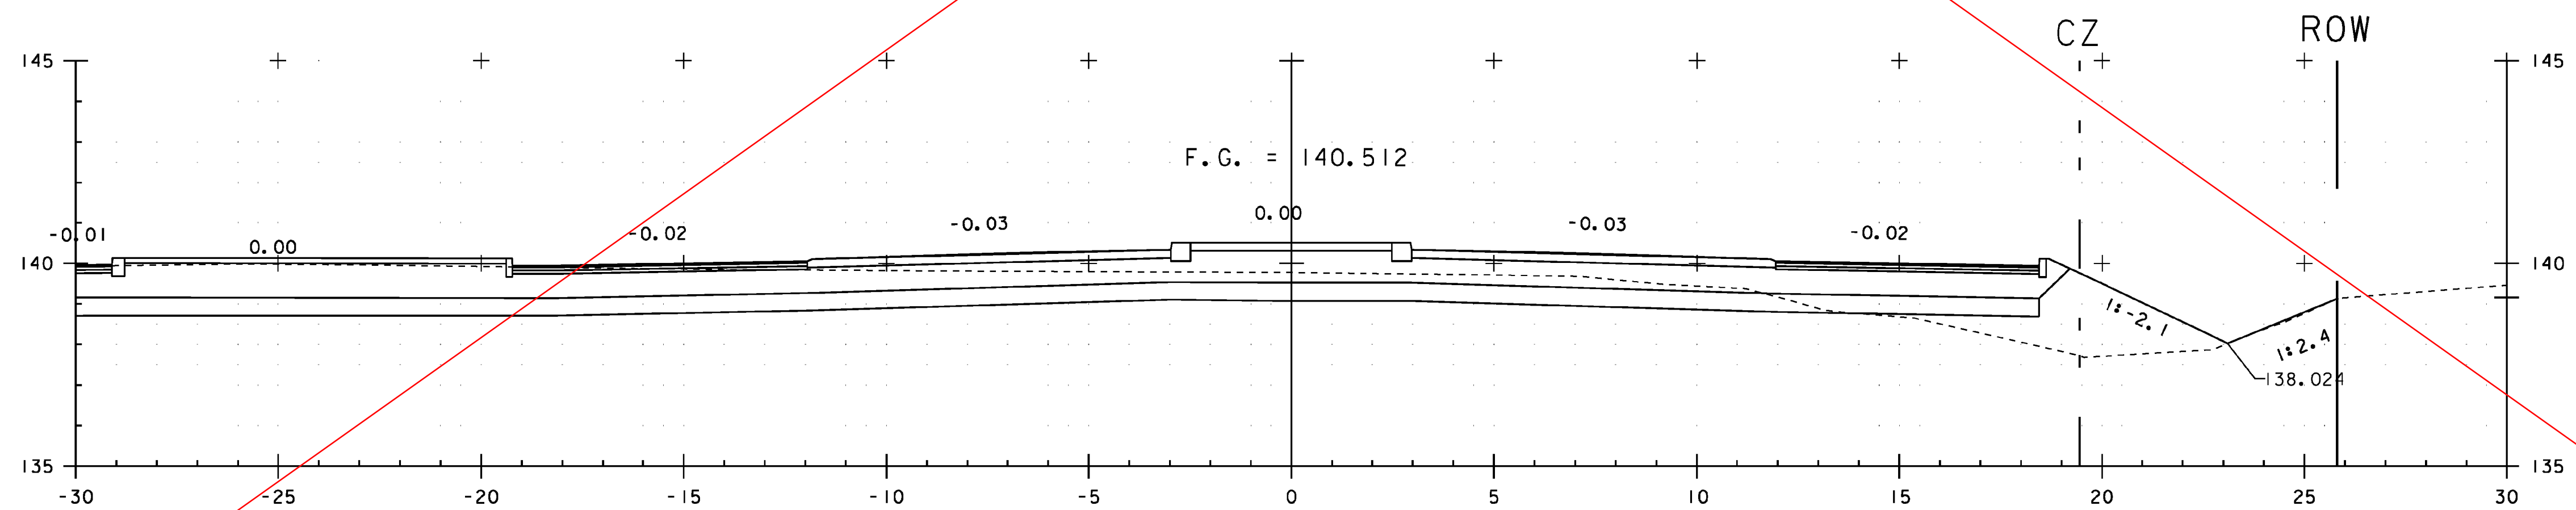

10+010.00

VT ROUTE 108

STA. 10+010 TO STA. 10+018

PROJECT NAME: CAMBRIDGE	PLOT DATE: 05 JUN-2012
PROJECT NUMBER: STP 030-2(27)	DRAWN BY: MBL
FILE NAME: +78f163xsl.dgn	CHECKED BY: JAD
PROJECT LEADER: JLS	SHEET 117 OF 214
DESIGNED BY: MBL	CROSS SECTION SHEET 36

SEE REVISION SHEET