


10+020.00

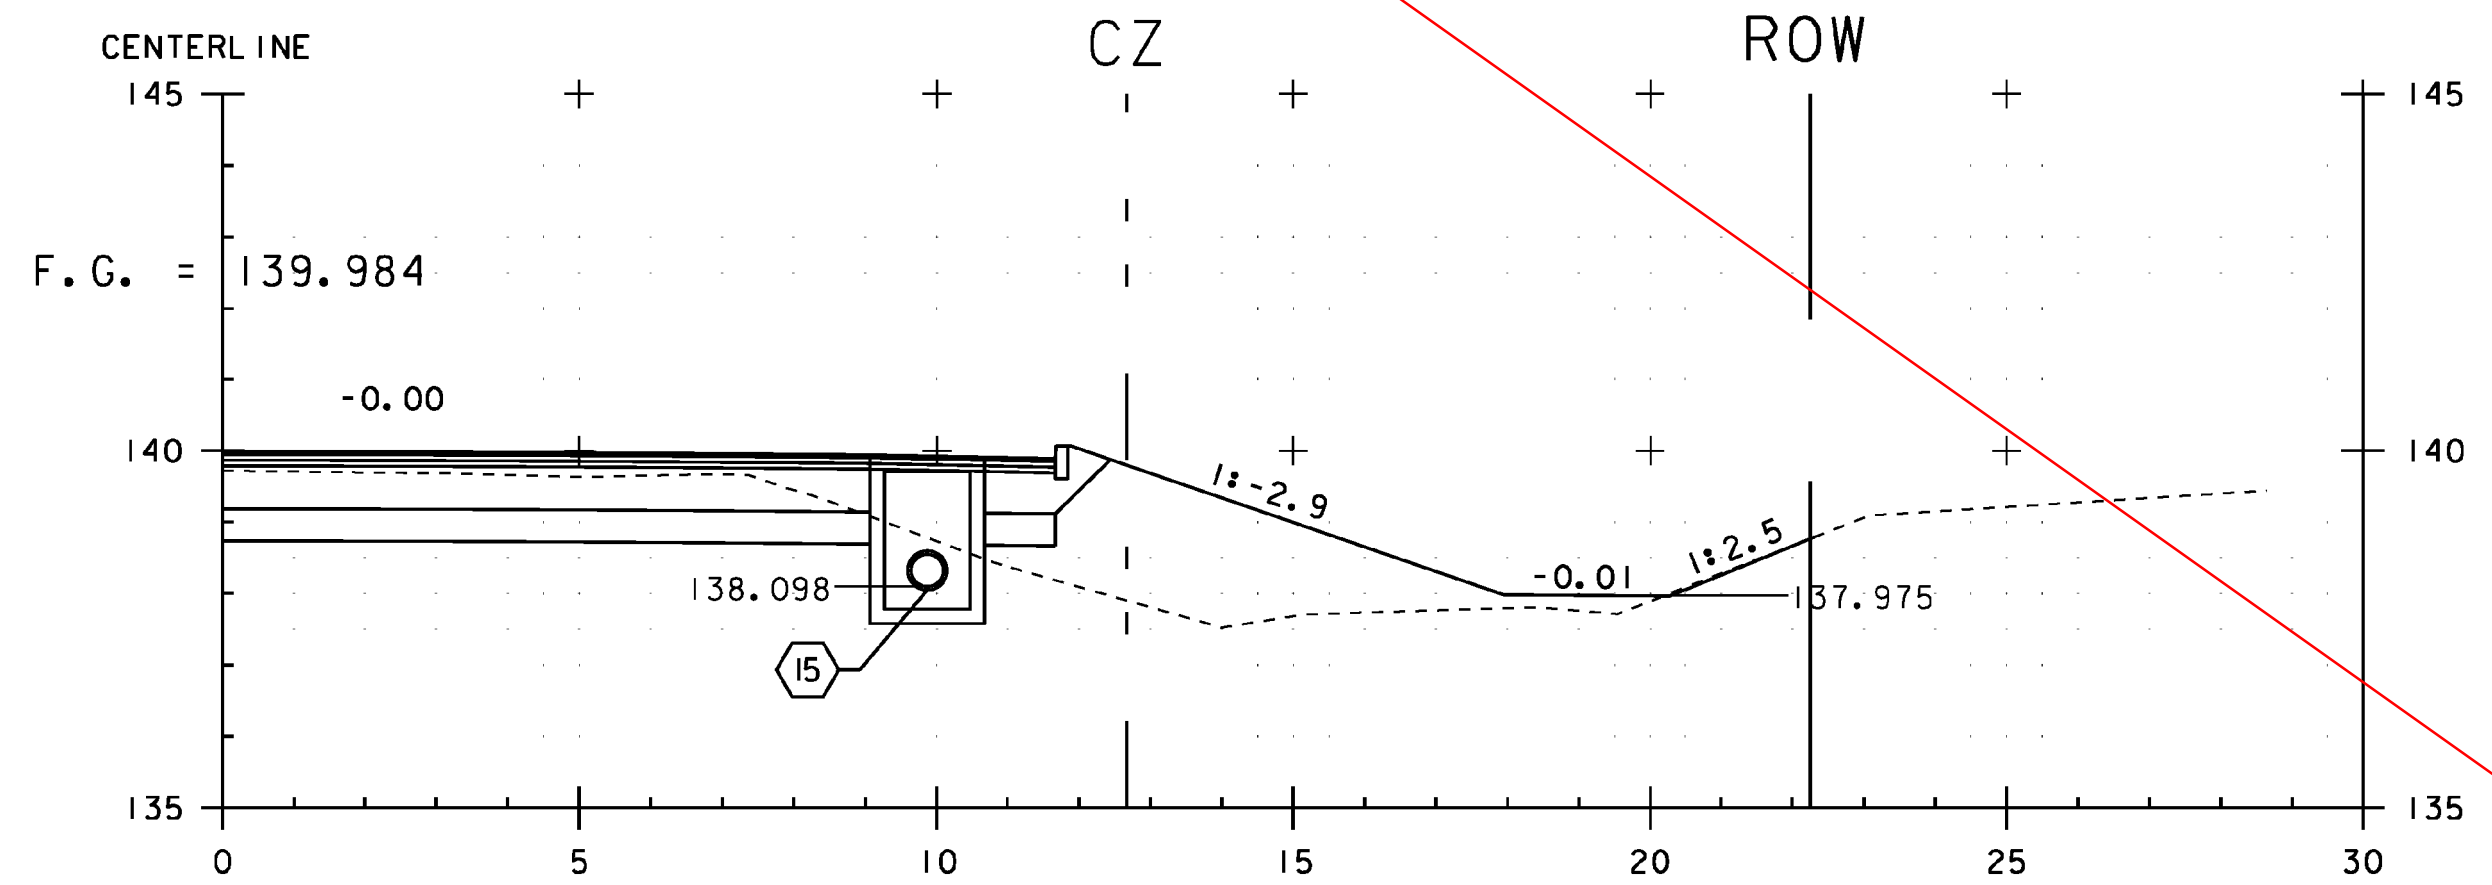

10+019.80

VT ROUTE 108

STA. 10+020 TO STA. 10+020

PROJECT NAME: CAMBRIDGE  
PROJECT NUMBER: STP 030-2(27)

FILE NAME: +78f163xsl.dgn  
PROJECT LEADER: JLS  
DESIGNED BY: MBL  
CROSS SECTION SHEET 37

PLOT DATE: 05 JUN-2012  
DRAWN BY: MBL  
CHECKED BY: JAD  
SHEET 118 OF 214

SEE REVISION SHEET