


10+030.00

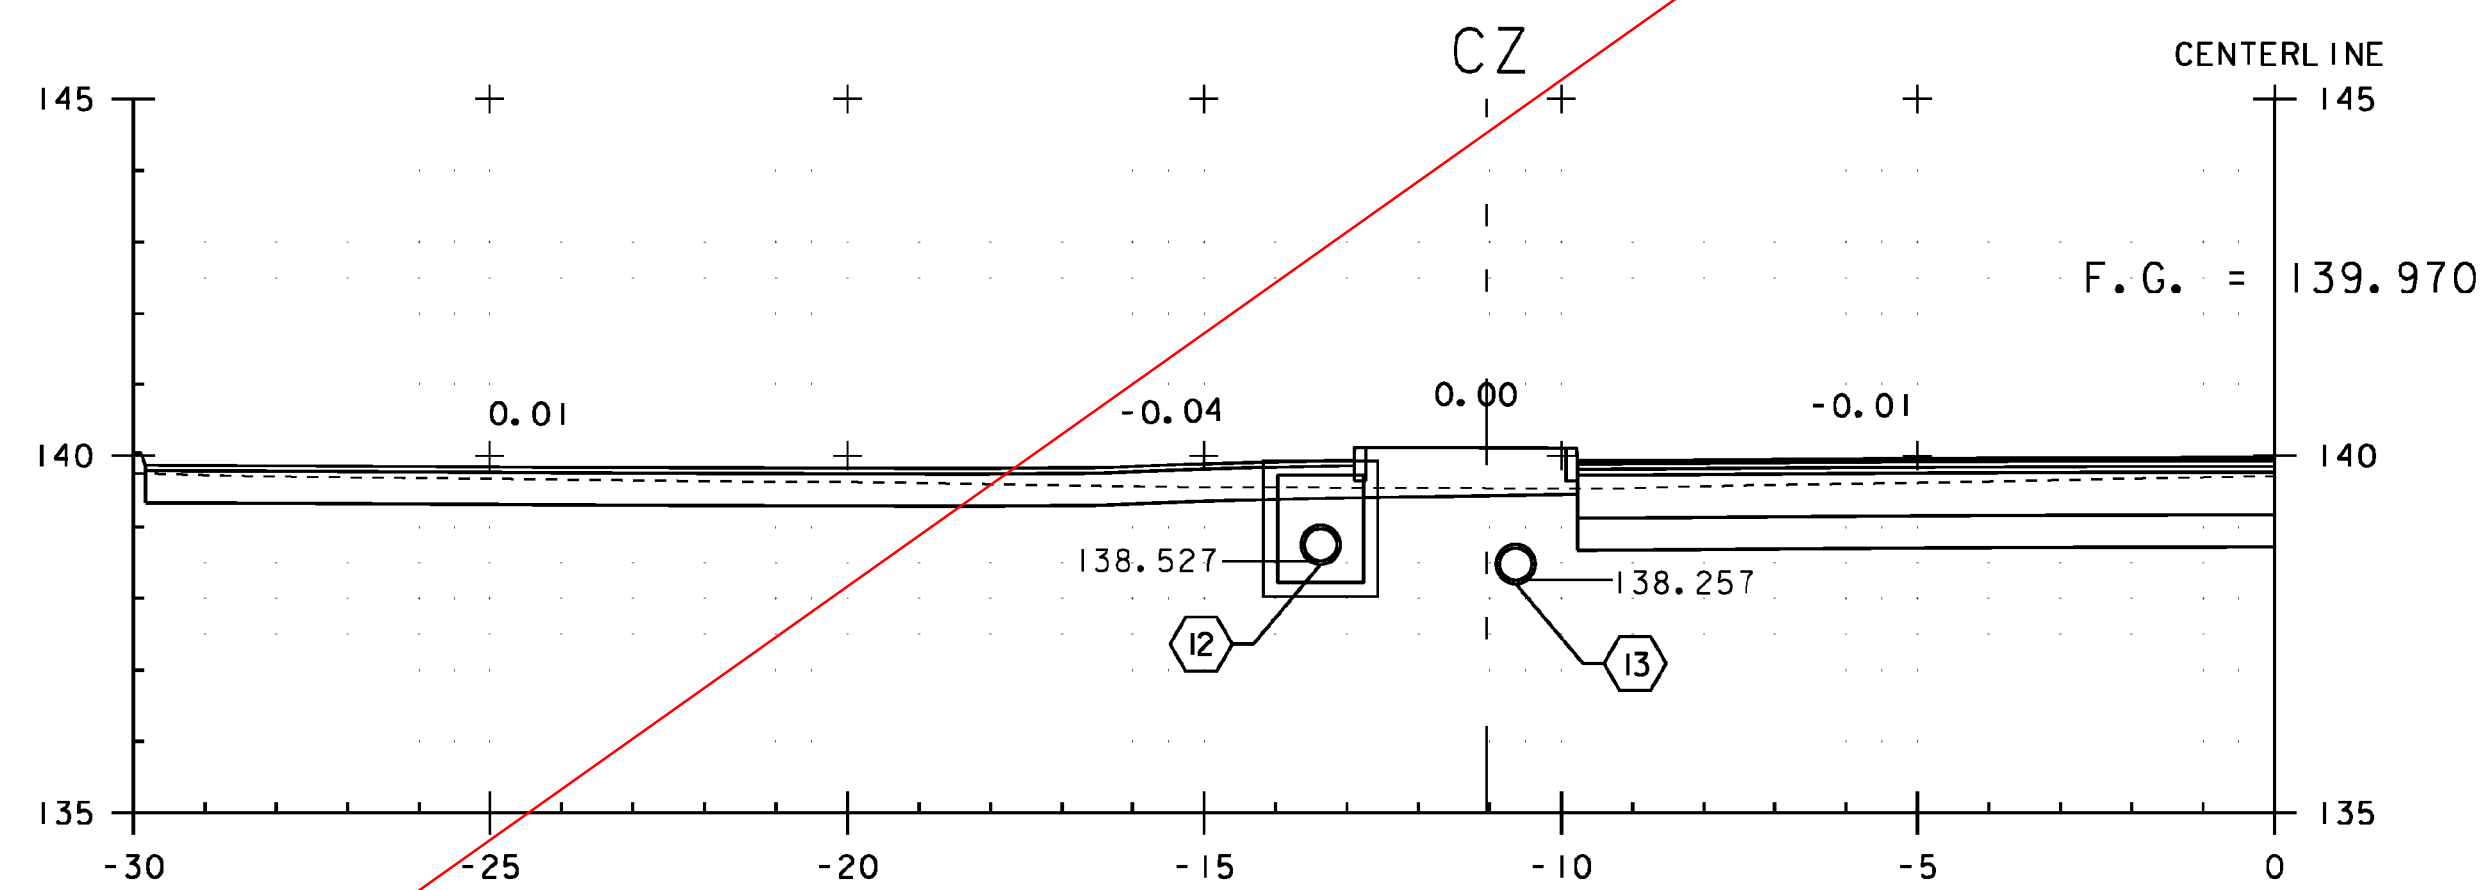

10+020.50

VT ROUTE 108

PROJECT NAME: CAMBRIDGE	PLOT DATE: 05-JUN-2012
PROJECT NUMBER: STP 030-2(27)	DRAWN BY: MBL
FILE NAME: +78f163xsl.dgn	CHECKED BY: JAD
PROJECT LEADER: JLS	SHEET 119 OF 214
DESIGNED BY: MBL	
CROSS SECTION SHEET 38	

STA. 10+020 TO STA. 10+030

SEE REVISION SHEET