


10+034.95

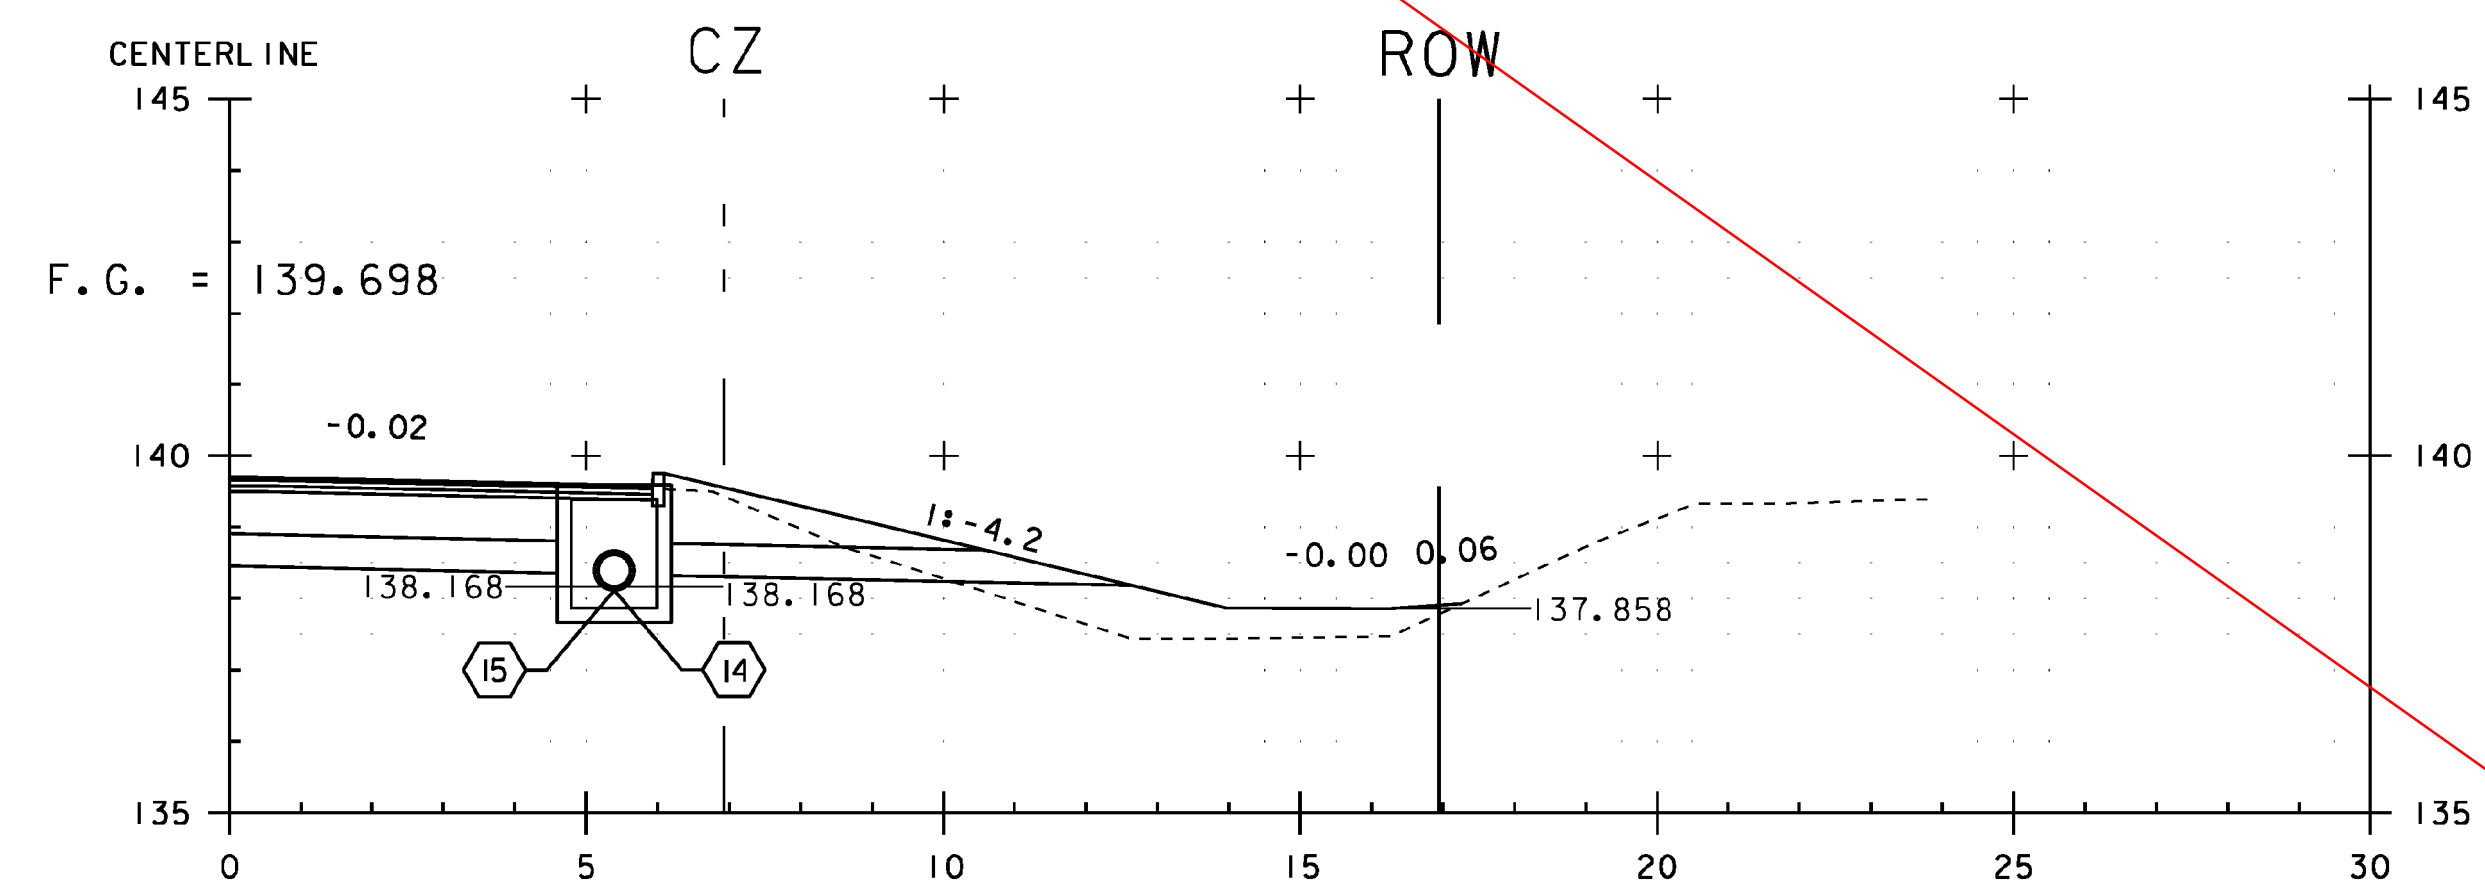

10+034.40

VT ROUTE 108

STA. 10+034 TO STA. 10+035

PROJECT NAME: CAMBRIDGE	PLOT DATE: 05 JUN-2012
PROJECT NUMBER: STP 030-2(27)	DRAWN BY: MBL
FILE NAME: +78f163xsl.dgn	CHECKED BY: JAD
PROJECT LEADER: JLS	SHEET 120 OF 214
DESIGNED BY: MBL	
CROSS SECTION SHEET 39	

SEE REVISION SHEET