


VT ROUTE 108

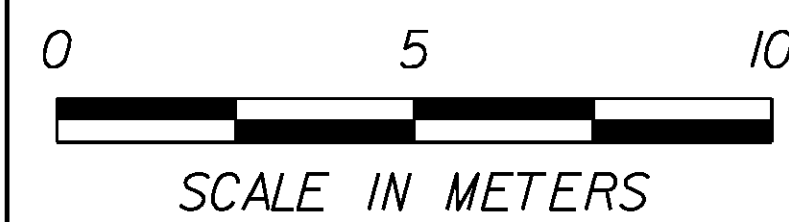

- $\triangle 1$  REVISED CB-11 RIM ELEVATION, BANKING AND SUBGRADE
- $\triangle 2$  REVISED CB-15 RIM ELEVATION, BANKING AND SUBGRADE

STA. 10+034 TO STA. 10+035

PROJECT NAME: CAMBRIDGE  
PROJECT NUMBER: STP 030-2(27)

FILE NAME: f78f163xsl.dgn  
PROJECT LEADER: JLS  
DESIGNED BY: MBL  
CROSS SECTION SHEET 39

PLOT DATE: 5/6/13  
DRAWN BY: MBL  
CHECKED BY: JAD  
SHEET 120 OF 214