


10+050.00

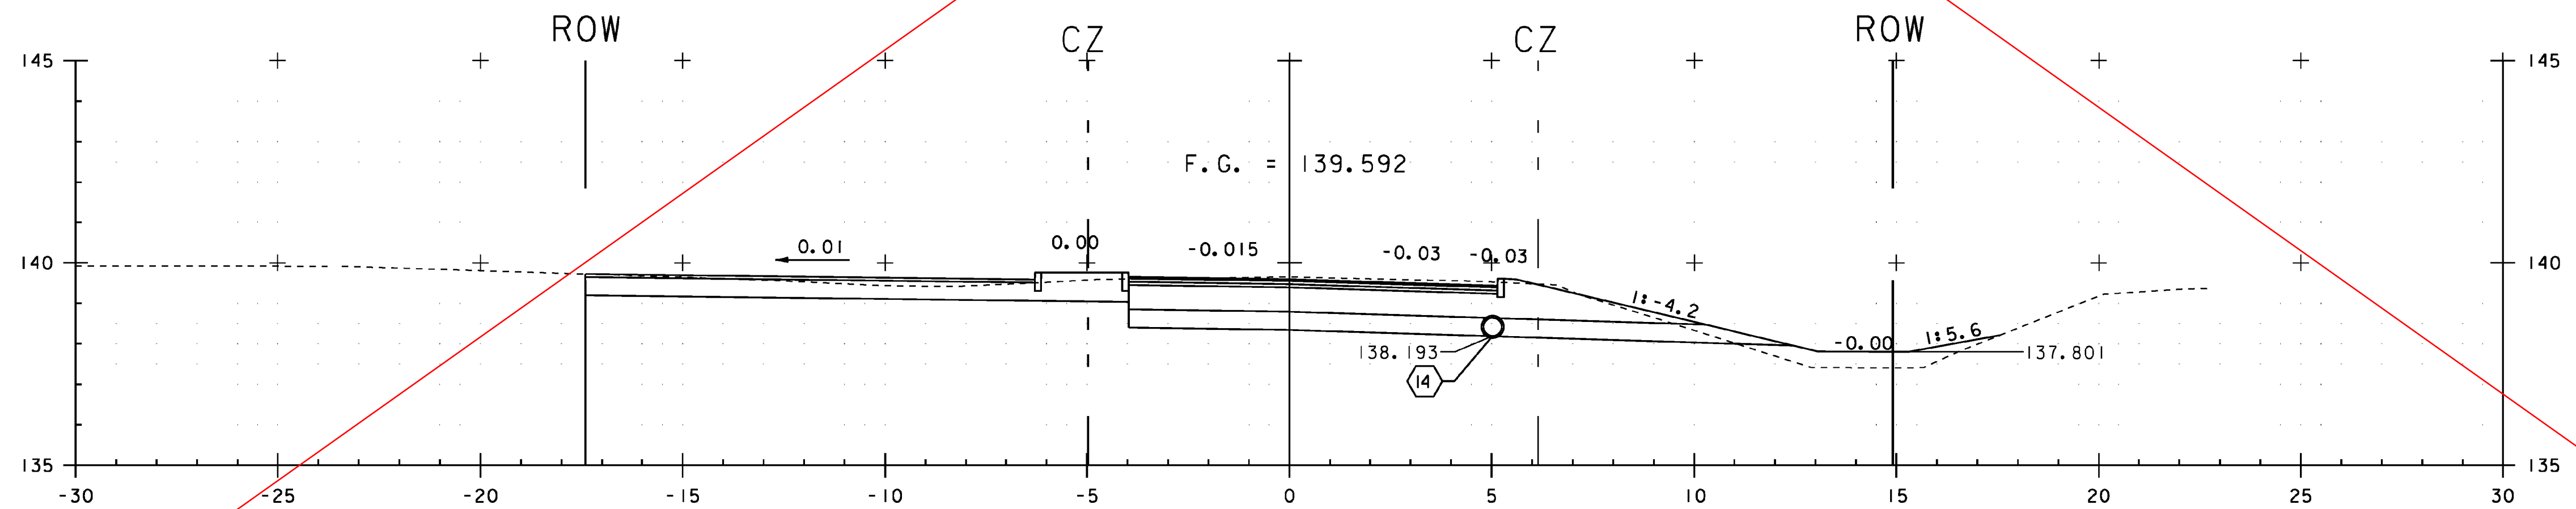

10+040.00

VT ROUTE 108

PROJECT NAME: CAMBRIDGE	PLOT DATE: 05 JUN-2012
PROJECT NUMBER: STP 030-2(27)	DRAWN BY: MBL
FILE NAME: +78f163xsl.dgn	CHECKED BY: JAD
PROJECT LEADER: JLS	SHEET 121 OF 214
DESIGNED BY: MBL	
CROSS SECTION SHEET 40	

STA. 10+040 TO STA. 10+050

SEE REVISION SHEET