



10+50.00

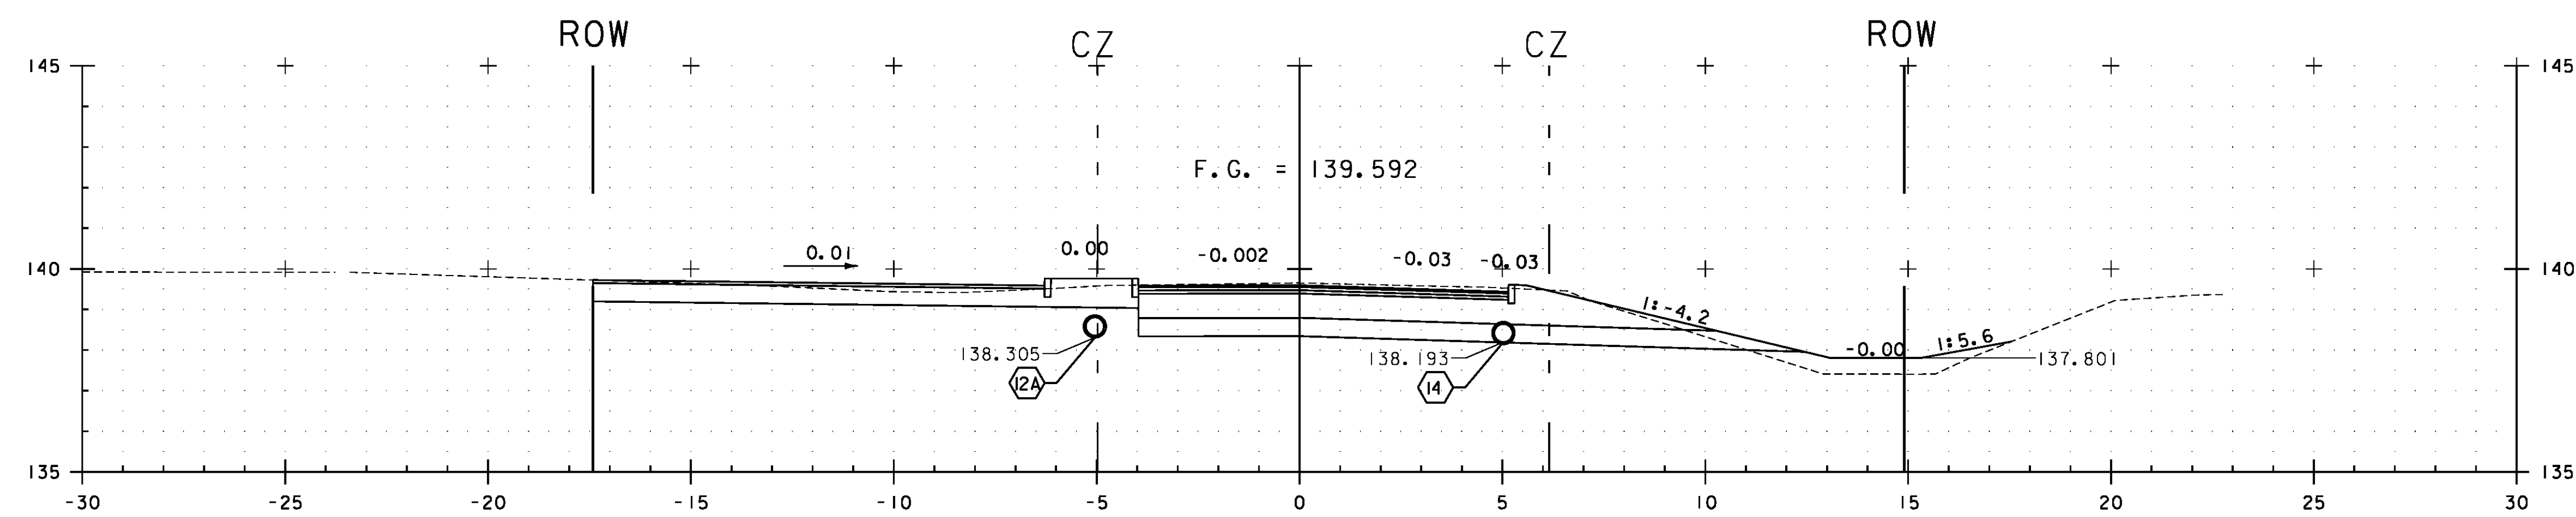

10+40.00

VT ROUTE 108

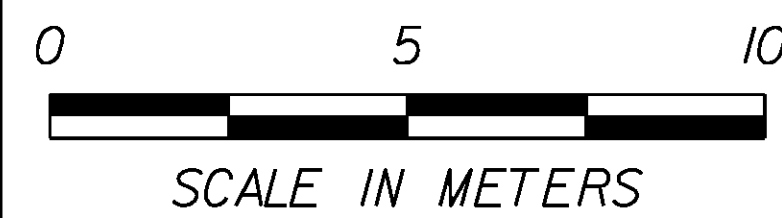

- REVISED BANKING AND SUBGRADE ON LEFT SIDE
- REVISED BANKING AND SUBGRADE ON LEFT SIDE
- ADDED PIPE 12A
- REVISED BANKING AND SUBGRADE OF PARKING LOT

STA. 10+040 TO STA. 10+050

PROJECT NAME: CAMBRIDGE
PROJECT NUMBER: STP 030-2(27)

FILE NAME: f78f163xsl.dgn
PROJECT LEADER: JLS
DESIGNED BY: MBL
CROSS SECTION SHEET 40

PLOT DATE: 6/24/13
DRAWN BY: MBL
CHECKED BY: JAD
SHEET 121 OF 214