


10+070.00

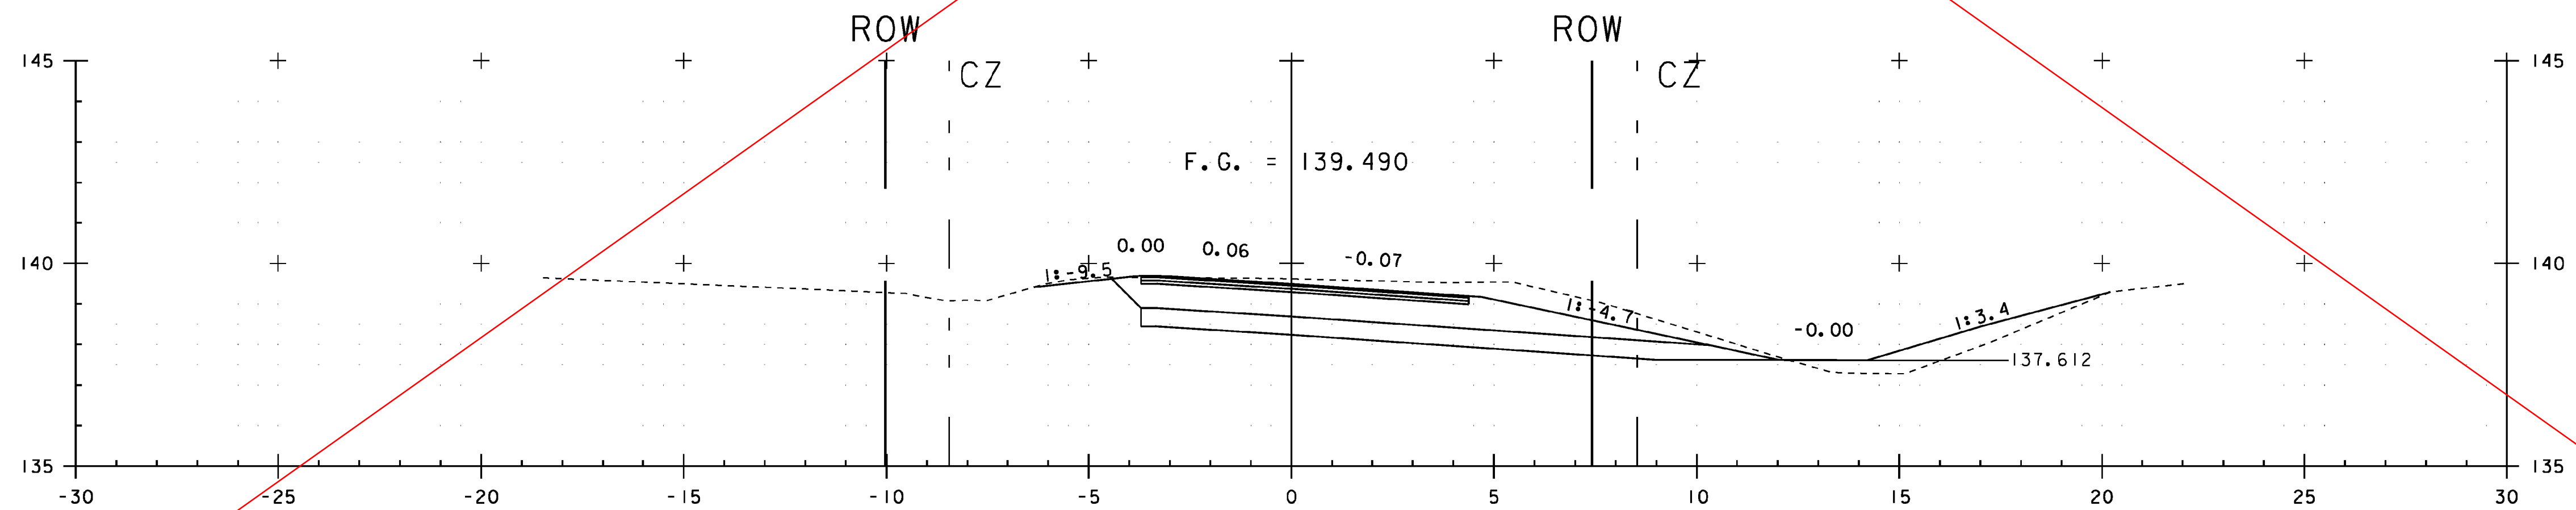

10+060.00

VT ROUTE 108

STA. 10+060 TO STA. 10+070

PROJECT NAME: CAMBRIDGE	PLOT DATE: 05 JUN-2012
PROJECT NUMBER: STP 030-2(27)	DRAWN BY: MBL
FILE NAME: +78f163xsl.dgn	CHECKED BY: JAD
PROJECT LEADER: JLS	SHEET 123 OF 214
DESIGNED BY: MBL	
CROSS SECTION SHEET 42	

SEE REVISION SHEET