


10+082.794  
 END PROJECT STP 030-2 (27)  
 BEGIN PROJECT BRF 027-1 (4)

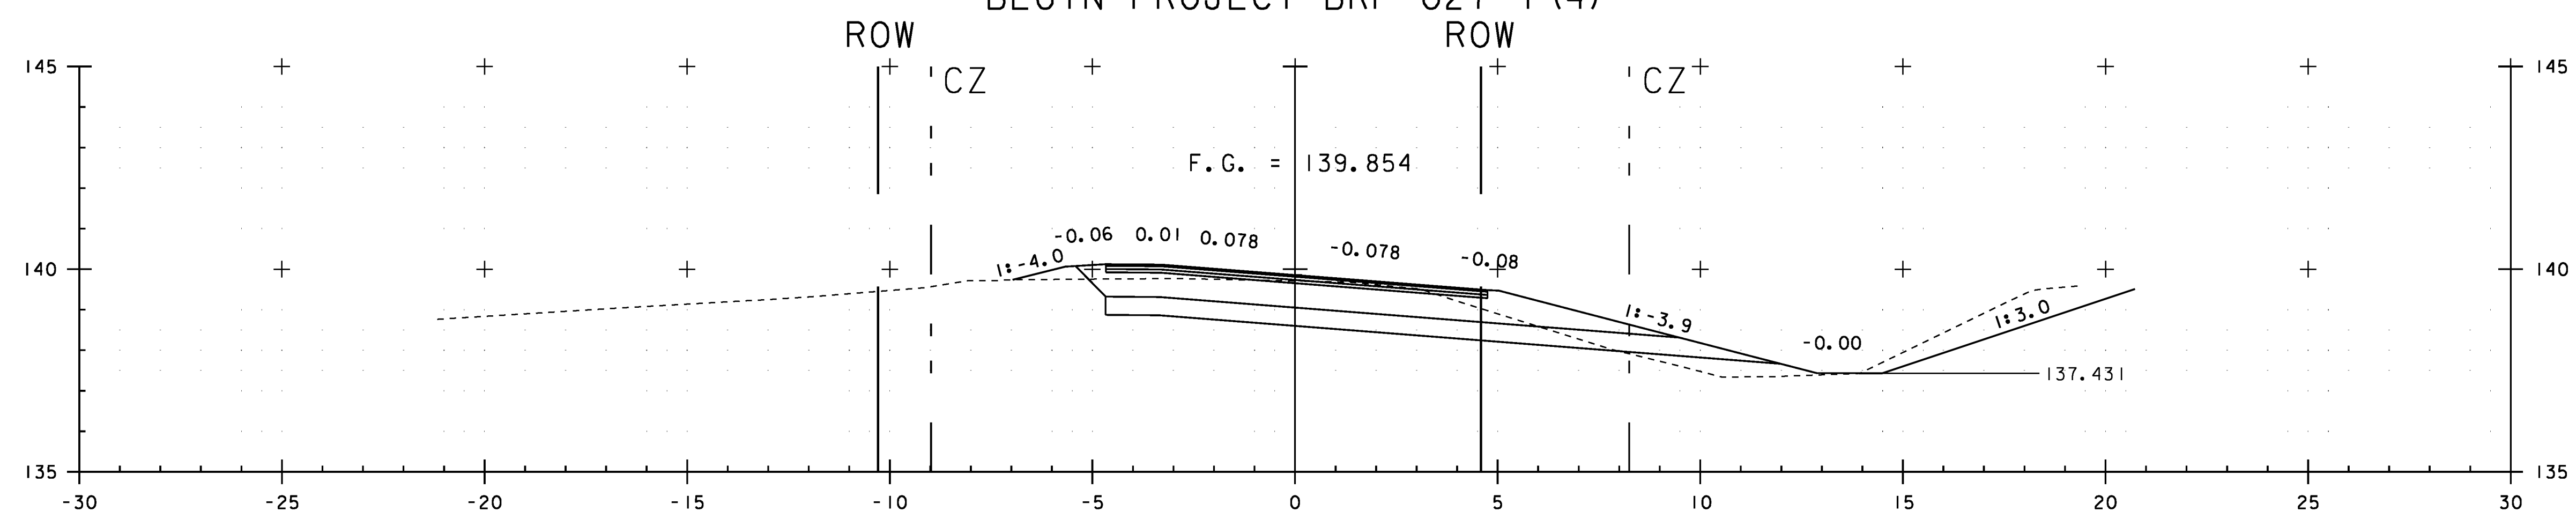

10+080.00

VT ROUTE 108

STA. 10+080 TO STA. 10+083

PROJECT NAME: CAMBRIDGE	PLOT DATE: 05-JUN-2012
PROJECT NUMBER: STP 030-2(27)	DRAWN BY: MBL
FILE NAME: +78f163xsl.dgn	CHECKED BY: JAD
PROJECT LEADER: JLS	SHEET 124 OF 214
DESIGNED BY: MBL	
CROSS SECTION SHEET 43	