

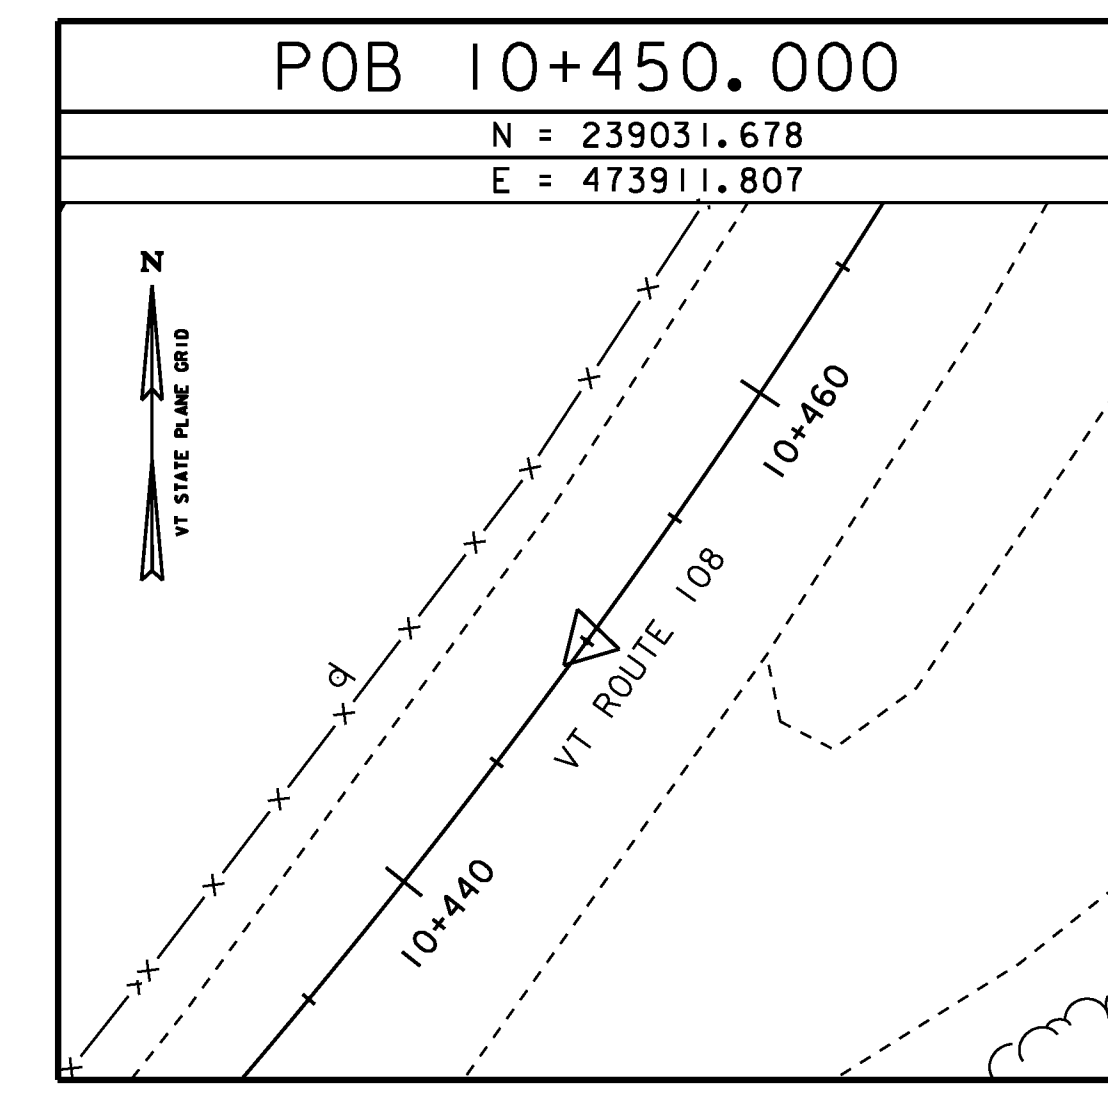


**ALIGNMENT TIES**

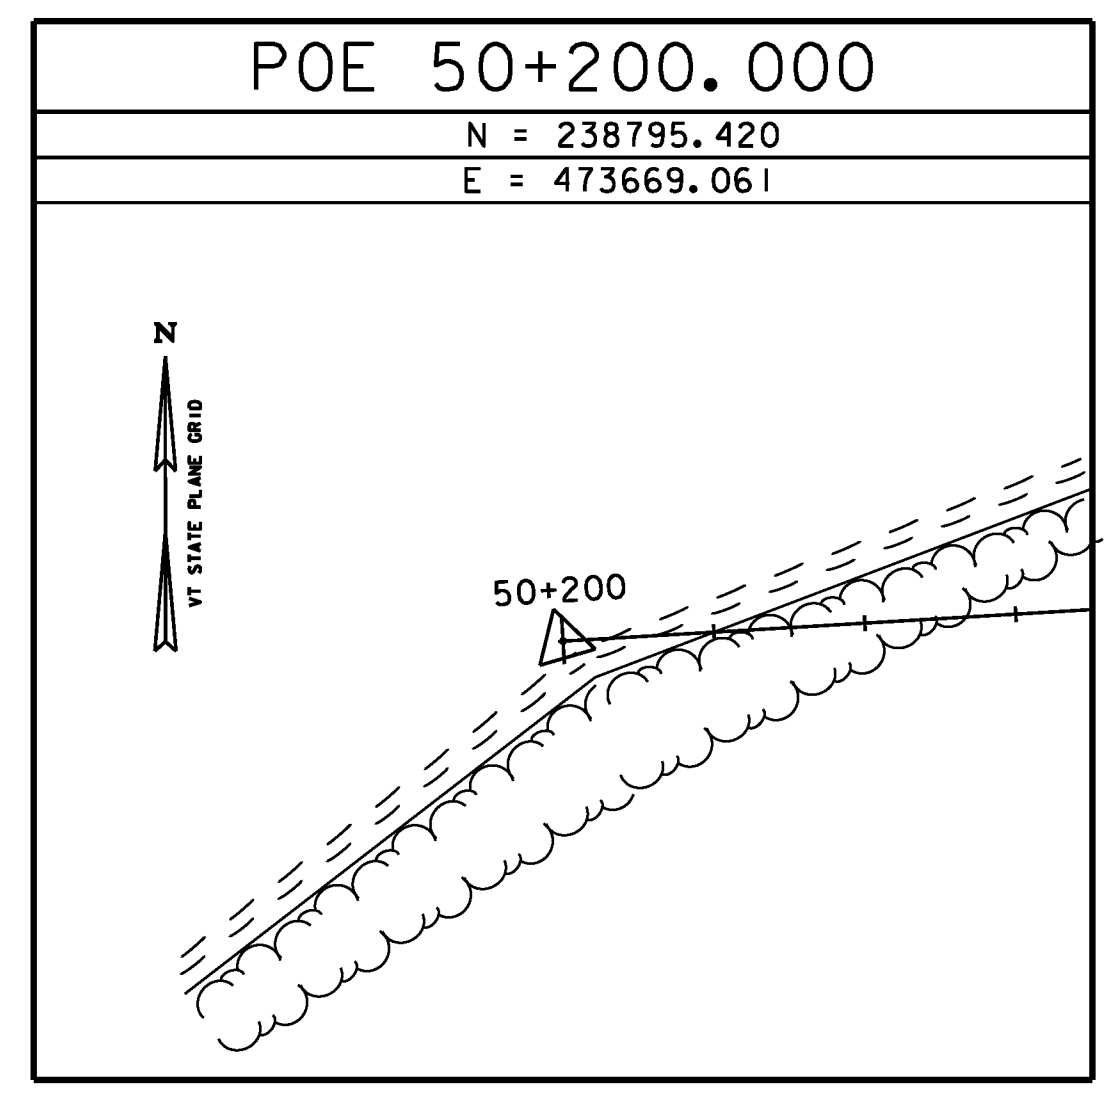

**ALIGNMENT TIES**

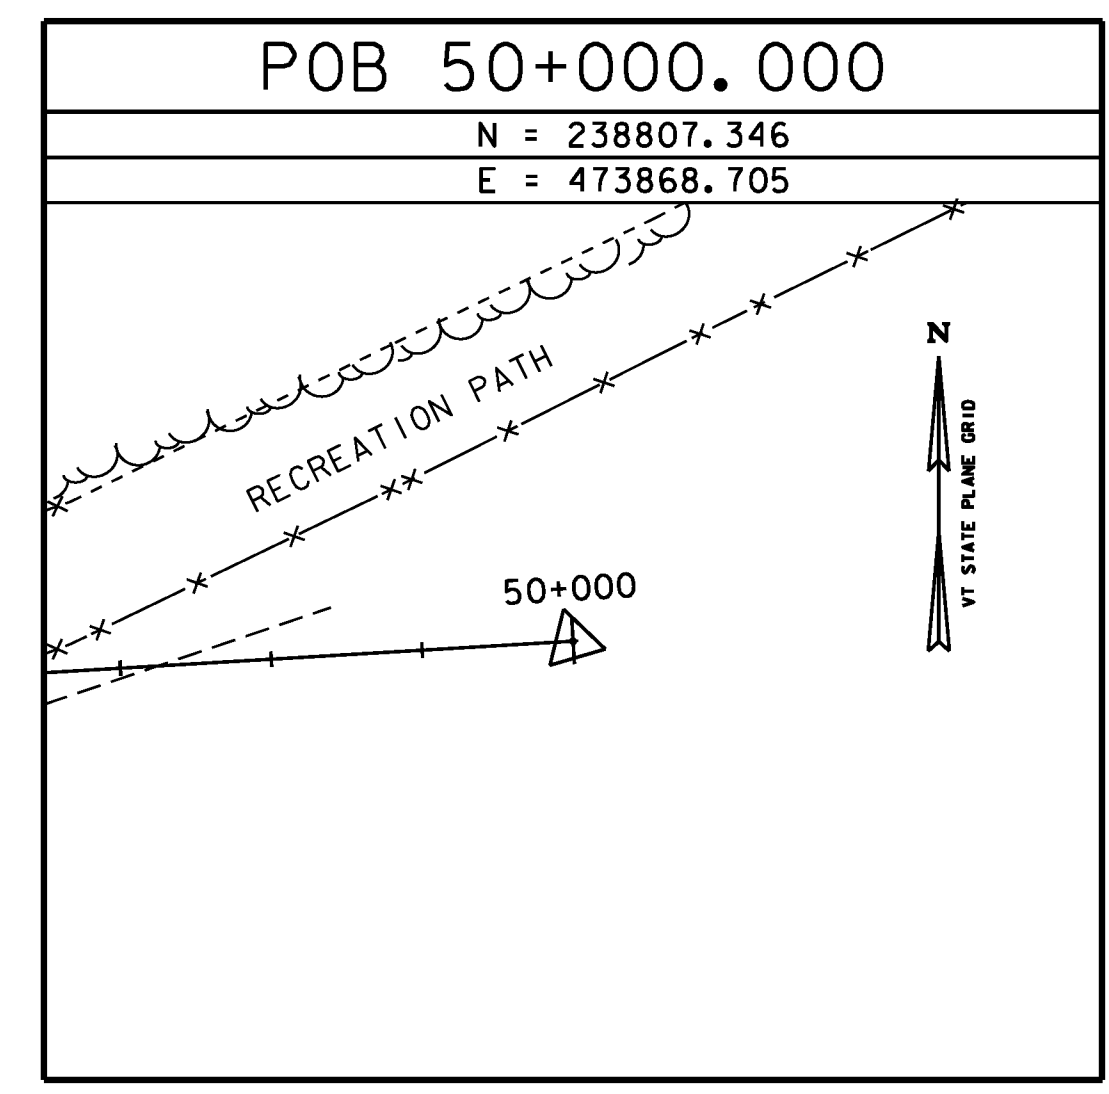