

MATERIAL ITEM	THICKNESS TOLERANCE (TOTAL DEPTH FOR EACH MATERIAL)
PAVEMENT (TOTAL DEPTH ALL LAYERS)	+/- 5
SUBBASE	+/- 30
SAND BORROW	+/- 30


TYPICAL SECTIONS

SEE W.O.#39

PAVEMENT: 40 SUPERPAVE BITUMINOUS CONCRETE PAVEMENT TYPE IVS
 160 65 SUPERPAVE BITUMINOUS CONCRETE PAVEMENT TYPE IIS
 550 SUBBASE OF DENSE GRADED CRUSHED STONE
 600 SAND BORROW


SHOULDERS: 40 SUPERPAVE BITUMINOUS CONCRETE PAVEMENT TYPE IVS
 65 SUPERPAVE BITUMINOUS CONCRETE PAVEMENT TYPE IIS

TACK COAT: EMULSIFIED ASPHALT IS TO BE APPLIED AT THE RATE OF 0.025 GAL/SY BETWEEN SUCCESSIVE COURSES OF PAVEMENT AS DIRECTED BY THE ENGINEER.

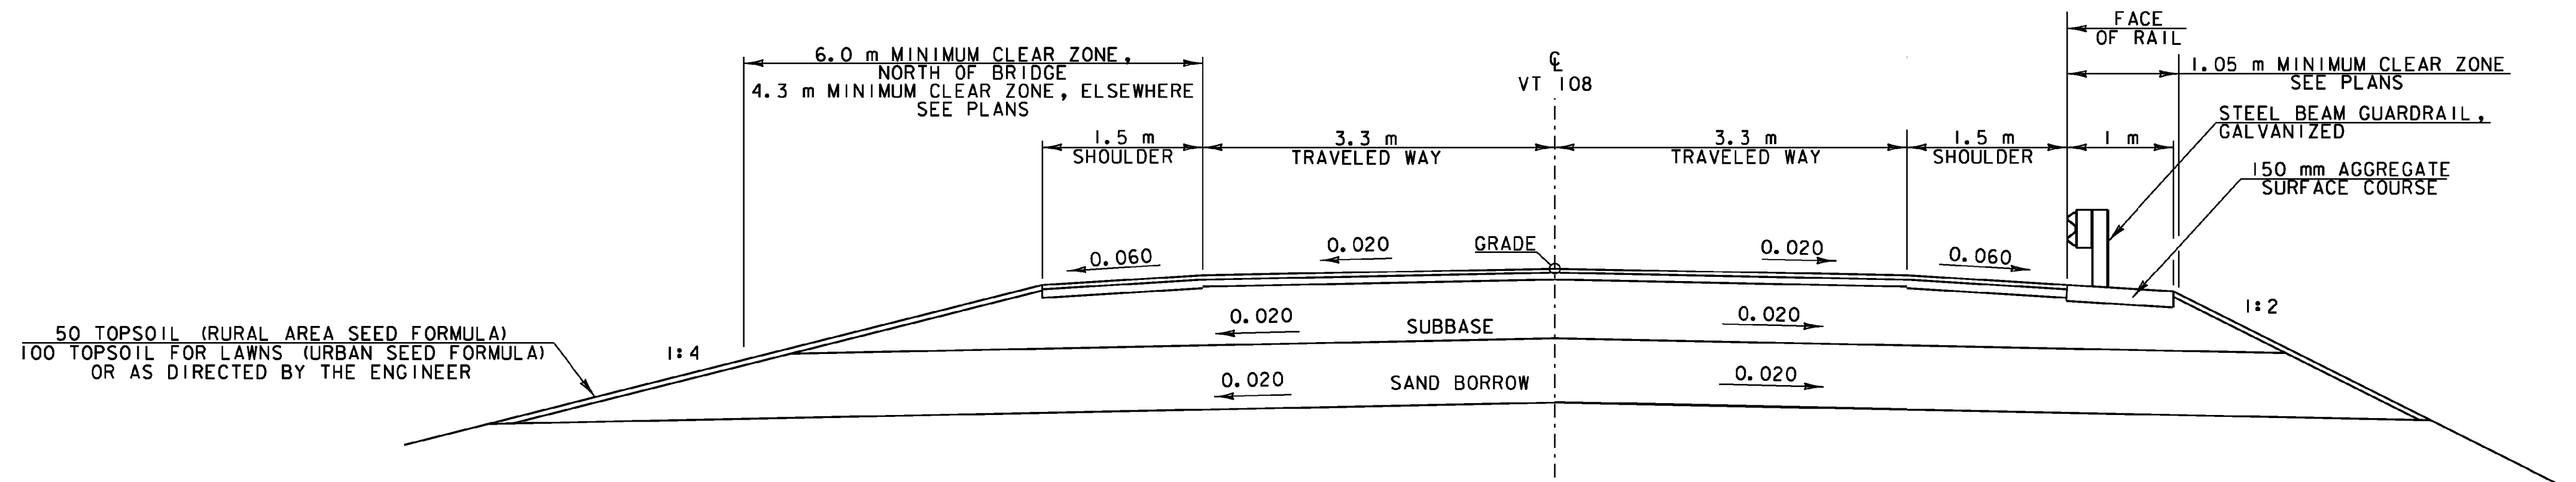


NORMAL SECTION WITHOUT GUARDRAIL

NORMAL SECTION WITH GUARDRAIL

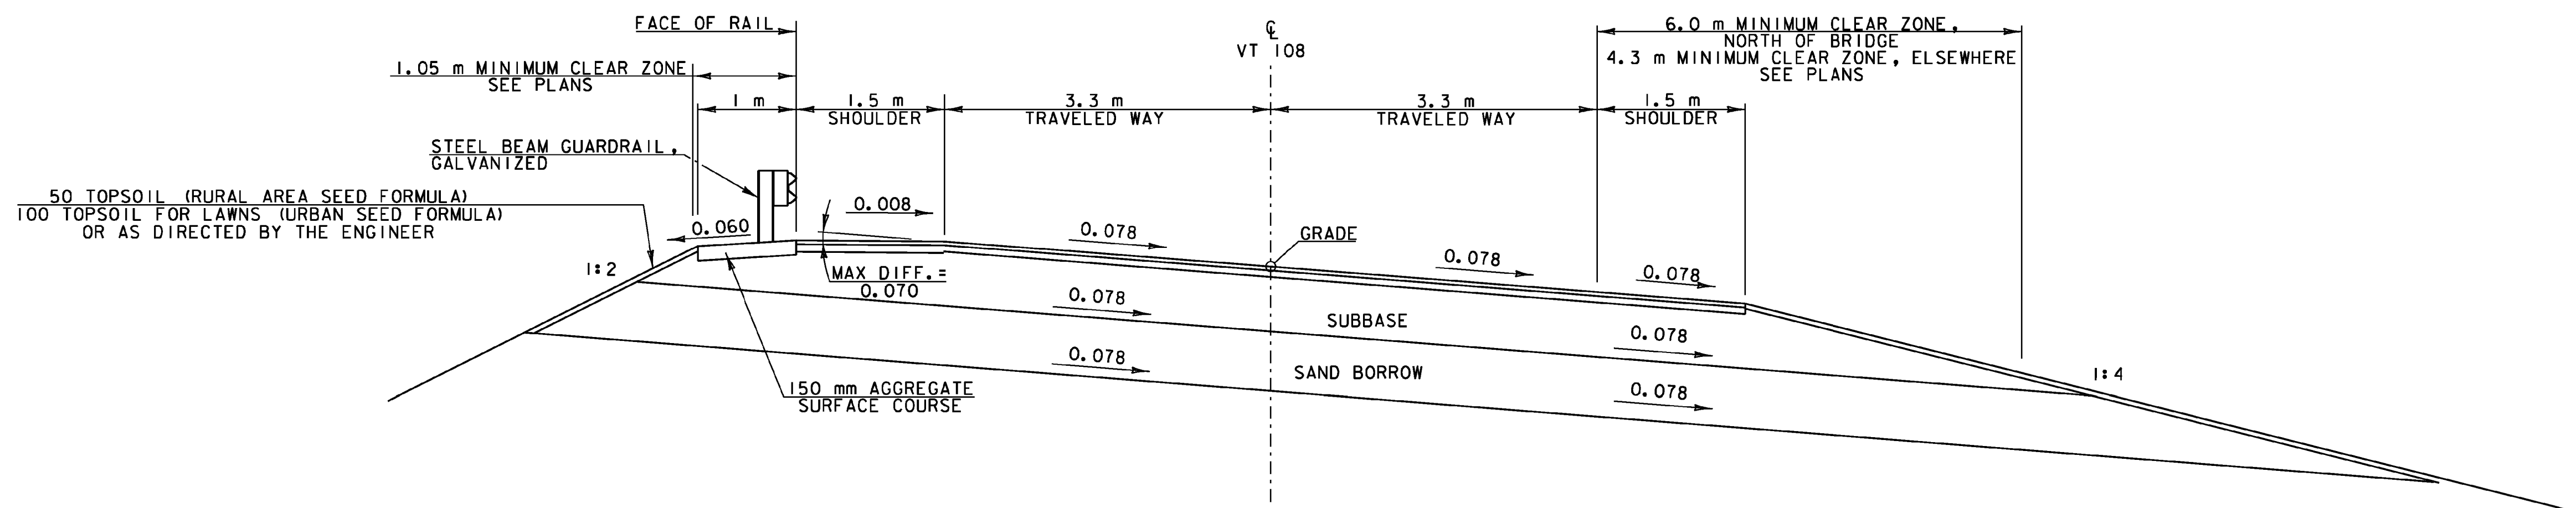


BANKED SECTION WITH GUARDRAIL


BANKED SECTION WITHOUT GUARDRAIL

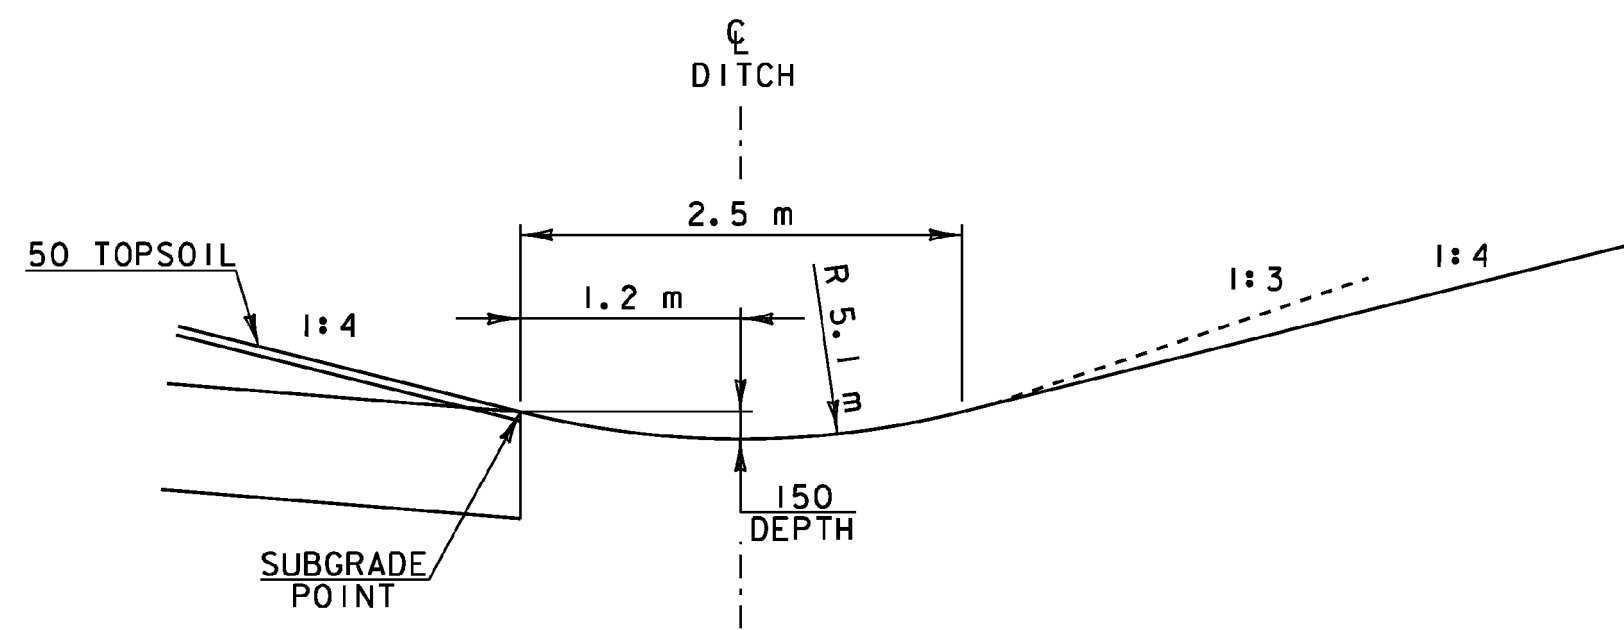

TYPICAL DITCH DETAIL ROUNDED

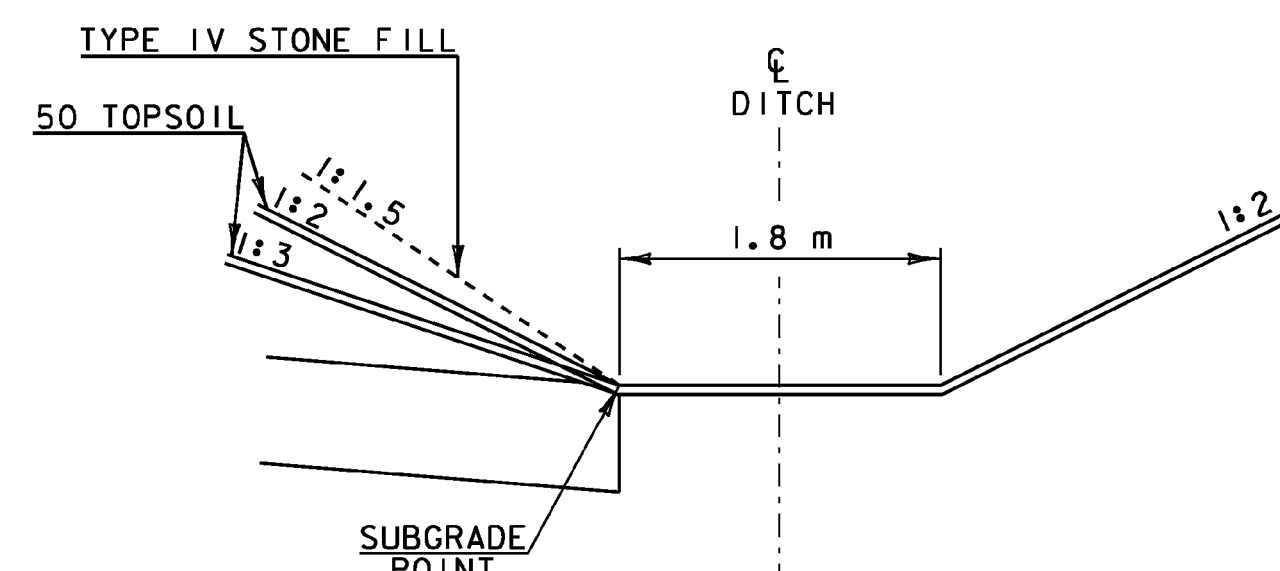

TYPICAL DITCH DETAIL TRAPEZOIDAL

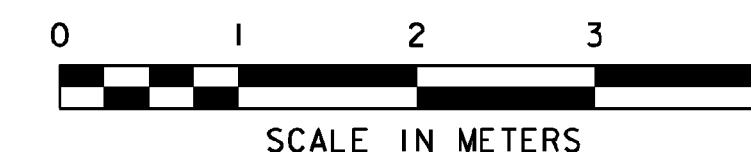

PROJECT NAME: CAMBRIDGE	PLOT DATE: 05-JUN-2012
PROJECT NUMBER: BRF 027-1(4)	DRAWN BY: G.ROKES
FILE NAME: s78f163typ.dgn	CHECKED BY: M.EVANSMONGEON
DESIGNED BY: T.FILBACH	TYPICAL ROADWAY SECTIONS
	SHEET 133 OF 214