

COLD PLANING, BITUMINOUS PAVEMENT

~~STA 10+476 - 10+495 - CL~~

CONSTRUCT DRIVE

STA 10+470 RT - 10.3m WIDE,  
11.3 m LONG, GRAVEL

REMOVAL OF EXISTING FENCE


~~STA 10+420 - 10+495 - LT~~

CONSTRUCT RECREATION PATH

(SEE ROADWAY CROSS SECTIONS)

STA 10+420 - 10+447 RT - 2.4m WIDE, GRAVEL FOOT PATH

CURVE #2 DATA  
 $\Delta = 33^\circ 31' 28''$  LT  
 R = 245.000  
 T = 73.794  
 L = 143.353  
 E = 10.872  
 BANK = 0.060

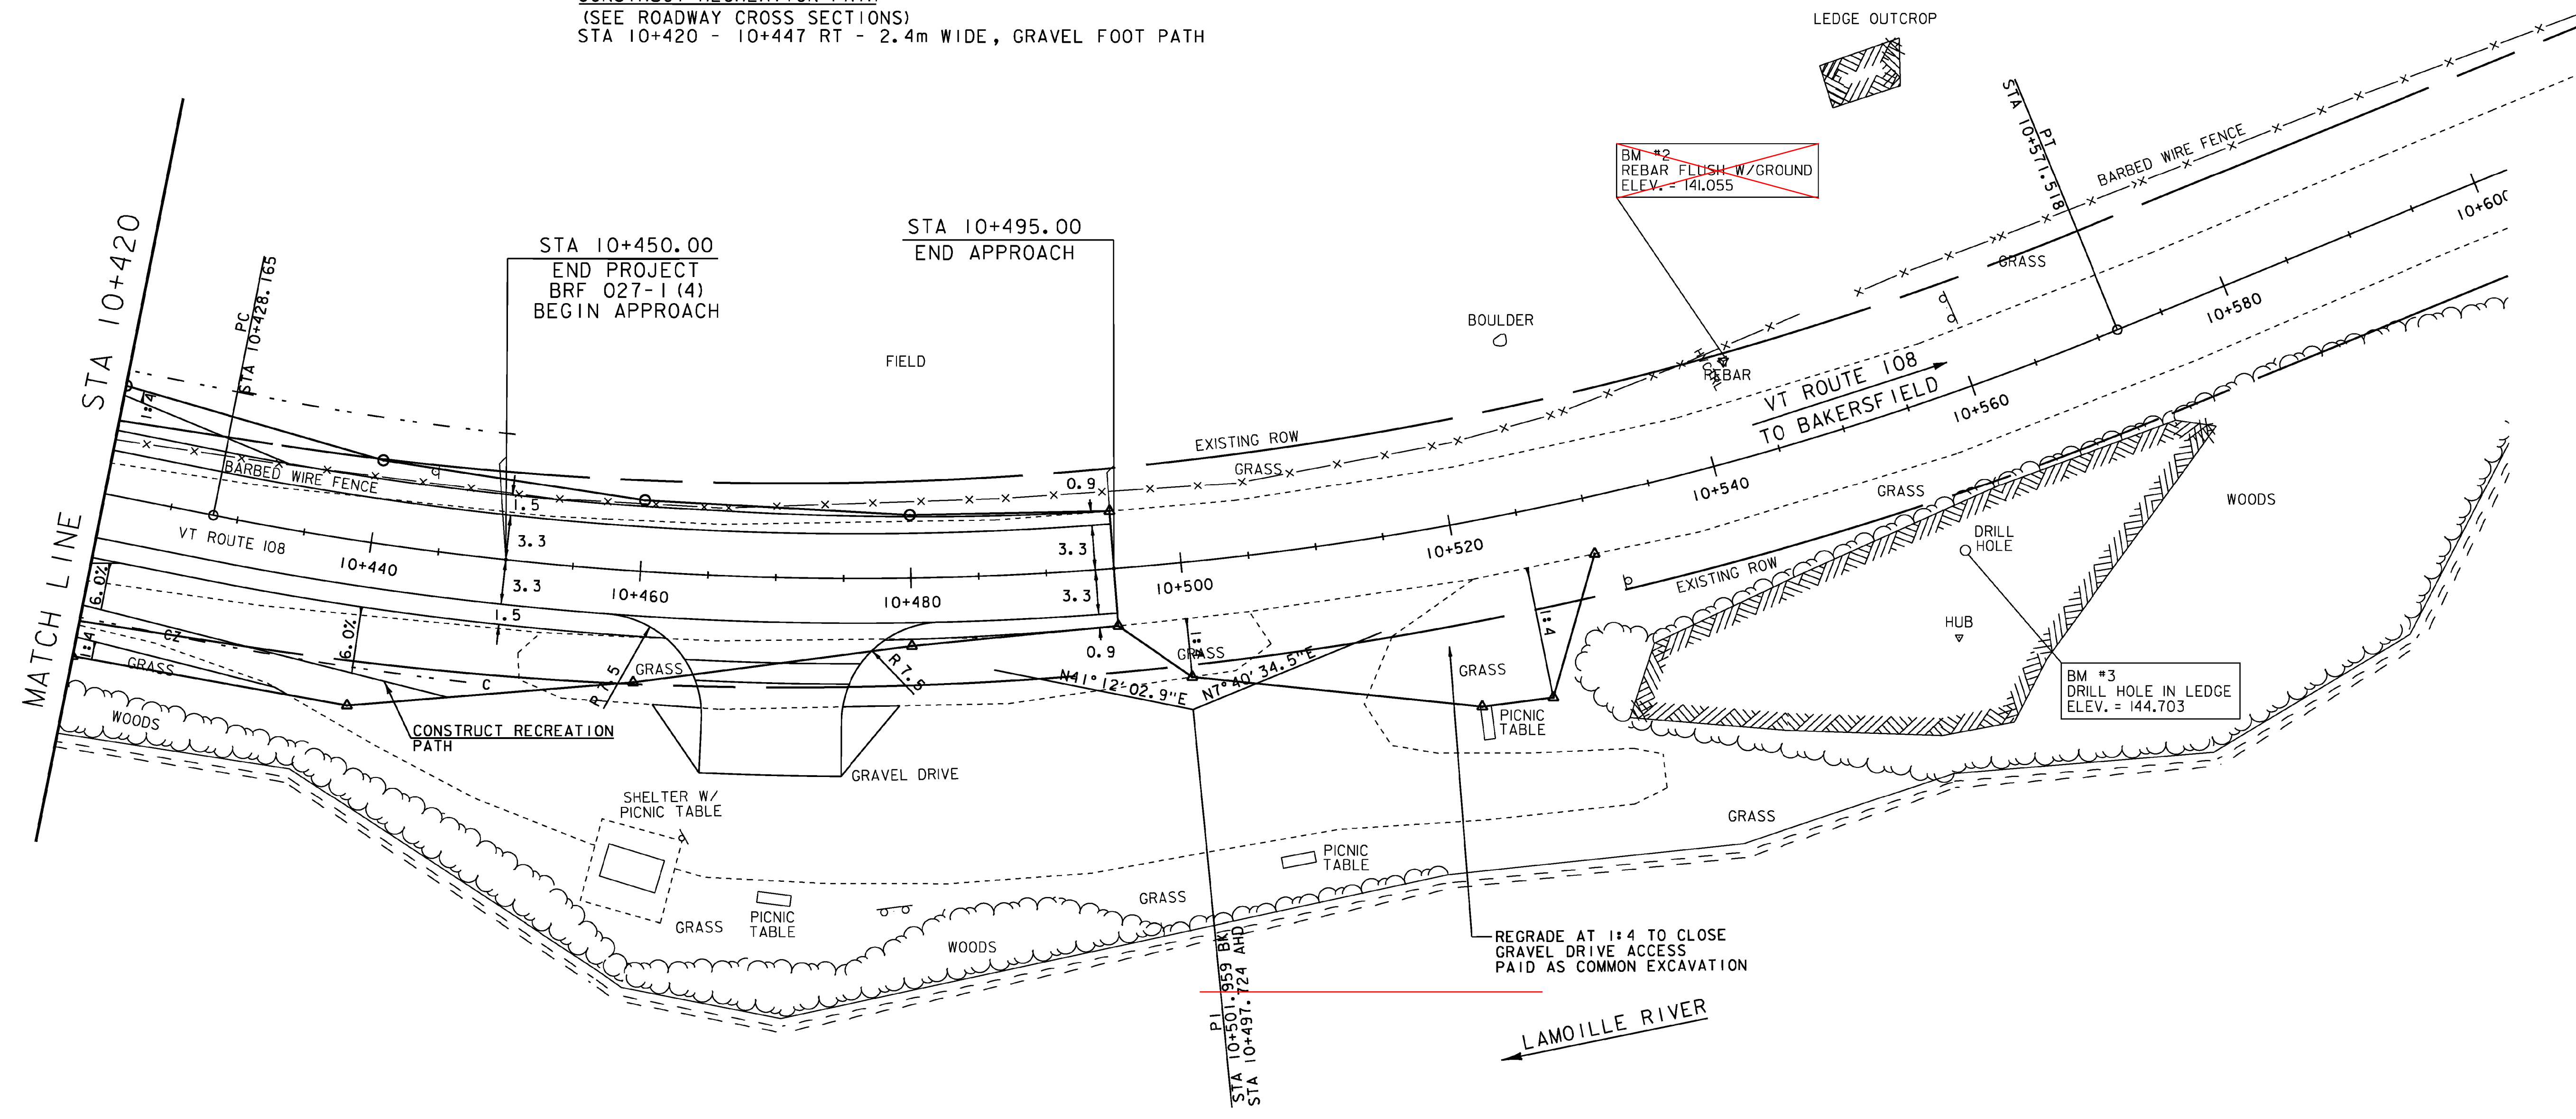

PROJECT NAME: CAMBRIDGE	PLOT DATE: 05-JUN-2012
PROJECT NUMBER: BRF 027-1 (4)	DRAWN BY: S. SCRIBNER
FILE NAME: structures/s78f163bdr.dgn	CHECKED BY: M.EVANS-MONGEON
PROJECT LEADER: M.EVANS-MONGEON	ROADWAY LAYOUT SHEET 3
DESIGNED BY: S. SCRIBNER	SHEET 144 OF 214