


← VT ROUTE 108 STA 10+082.794
 END PROJECT STP 030 -2 (27)
 BEGIN PROJECT BRF 027 -1 (4)

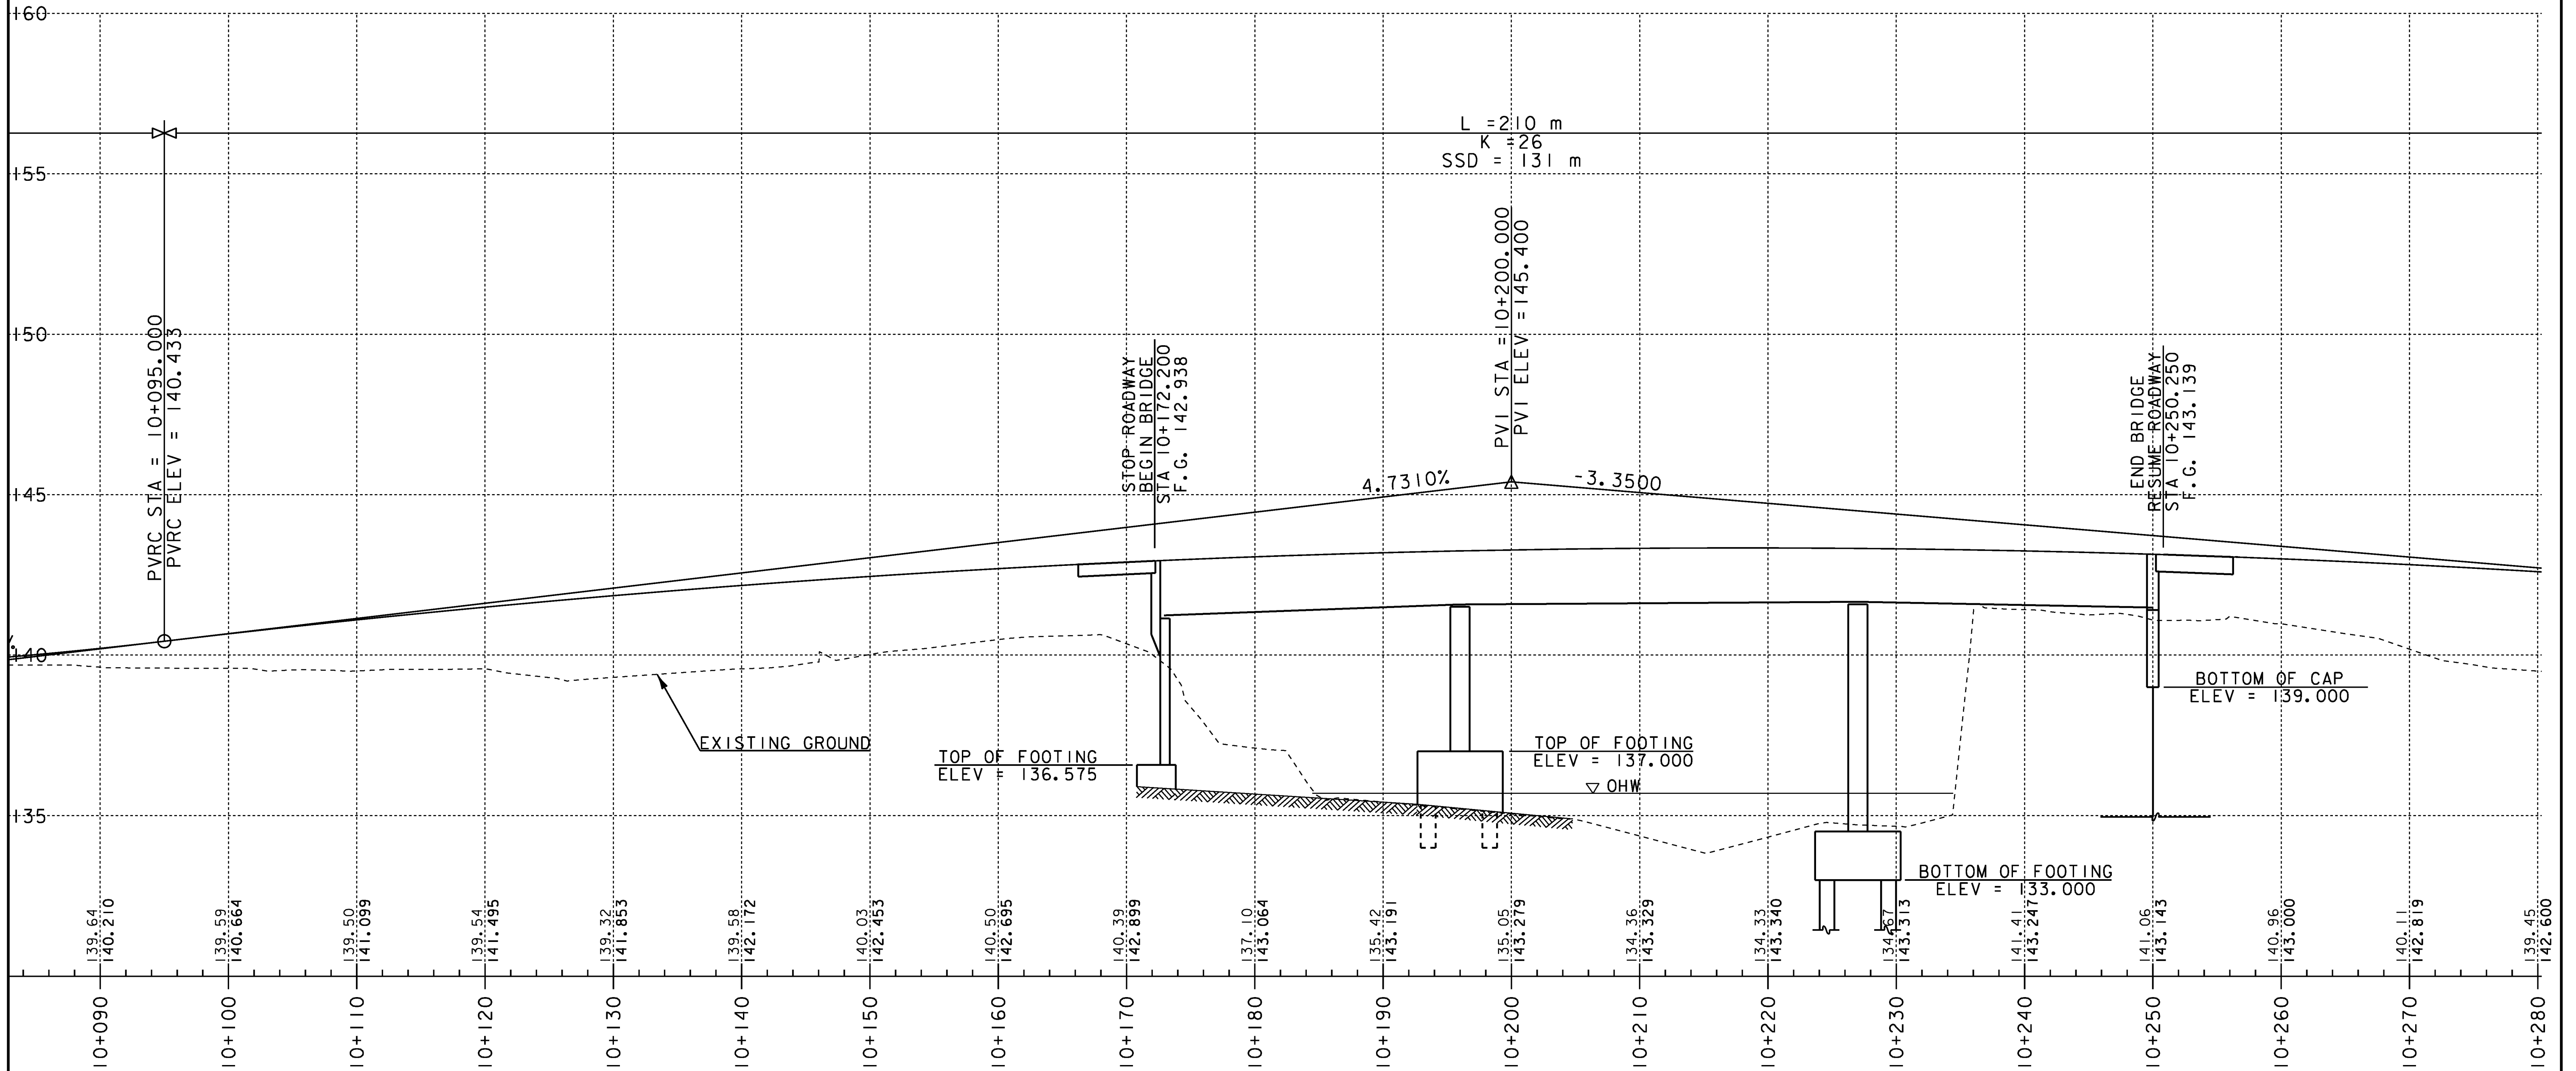

PROFILE NOTES:
 EXISTING ELEVATIONS ARE SHOWN TO 0.01 METERS.
 PROPOSED ELEVATIONS ARE SHOWN TO 0.001 METERS.

PROJECT NAME:	CAMBRIDGE	PLOT DATE:	05-JUN-2012
PROJECT NUMBER:	BRF 027-1 (4)	DRAWN BY:	G. ROKES
FILE NAME:	s78f163probdr.dgn	CHECKED BY:	M.EVANS-MONGEON
PROJECT LEADER:	M. EVANS-MONGEON	DESIGNED BY:	T. FILBACH
PROFILE SHEET 1			SHEET 145 OF 214