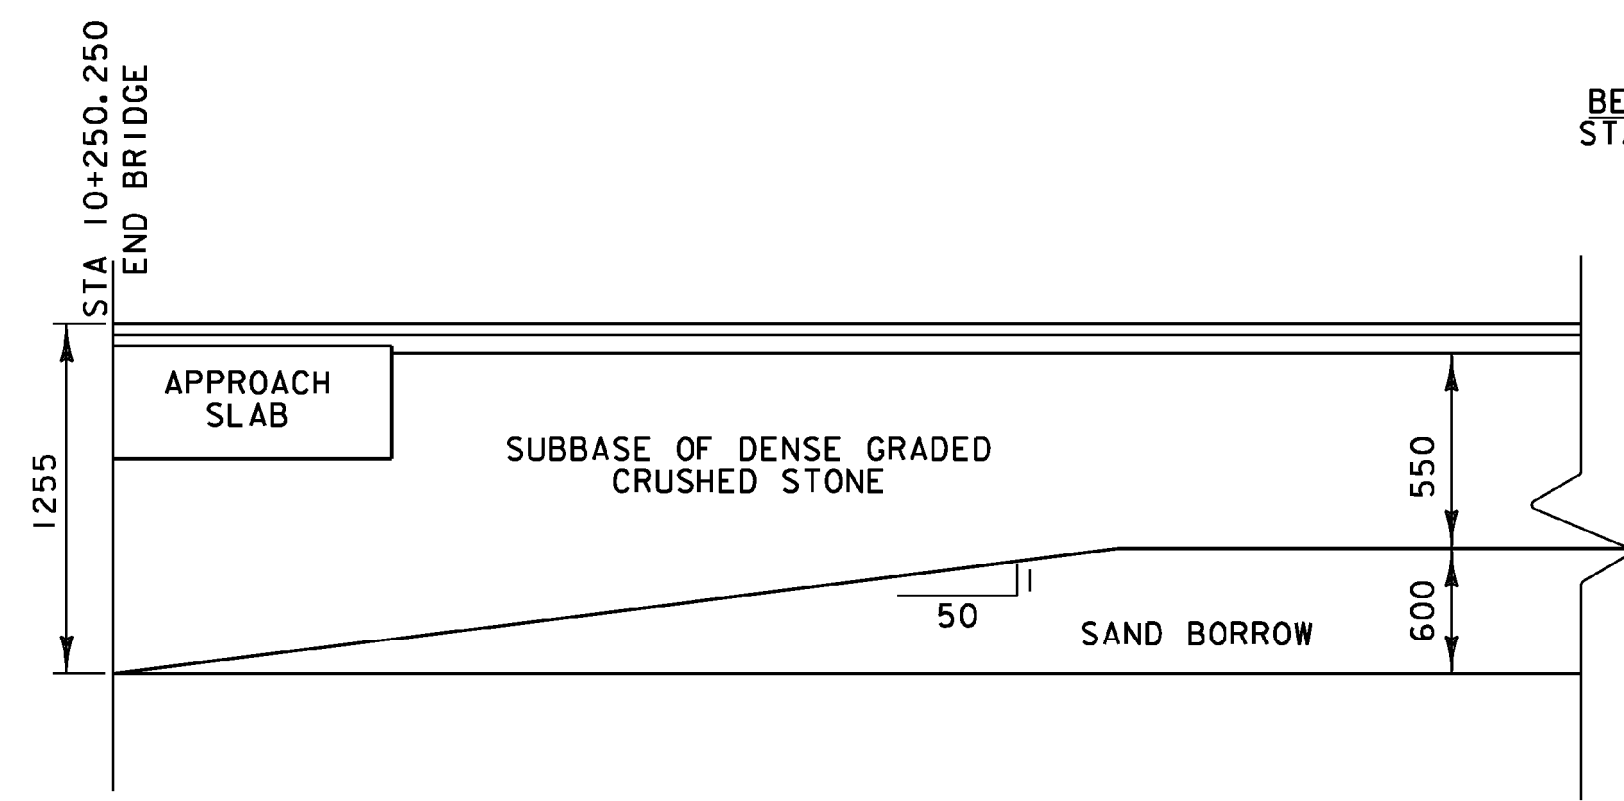
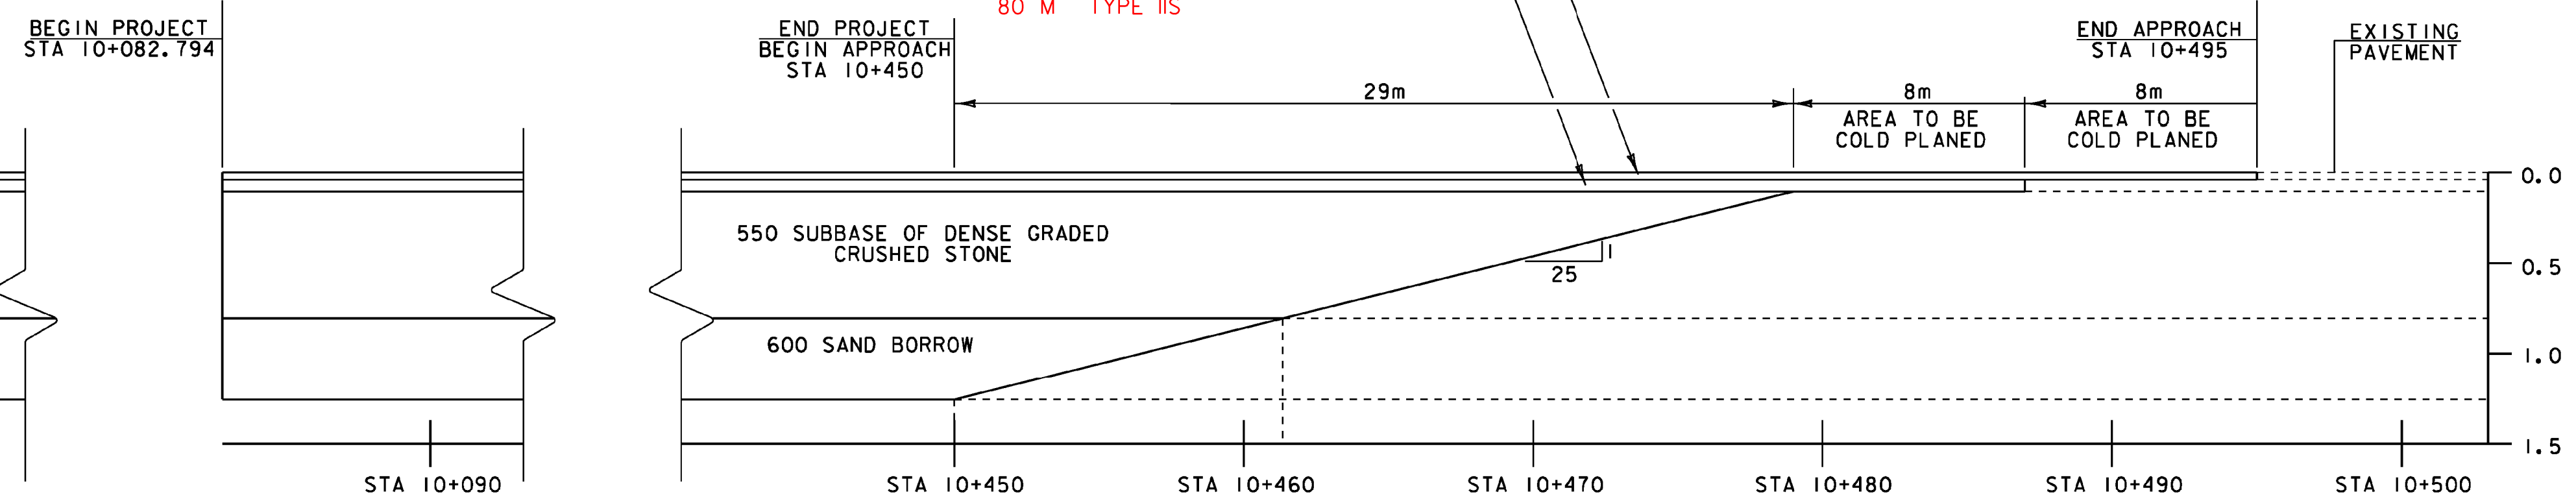

VT ROUTE 108

**END OF BRIDGE TRANSITION
(BEGIN BRIDGE SIMILAR)**

VT ROUTE 108 TRANSITION

PROJECT NAME:	CAMBRIDGE	PLOT DATE:	
PROJECT NUMBER:	BRF 027-1 (4)	DRAWN BY:	G. ROKES
FILE NAME:	s78f163+yp.dgn	CHECKED BY:	M.EVANSMONGEON
PROJECT LEADER:	M.EVANSMONGEON	MATERIAL TRANSITION DETAILS & BANKING DIAGRAM	SHEET 148 OF 214
DESIGNED BY:	T. FILBACH		