




TOP FLANGE PLAN

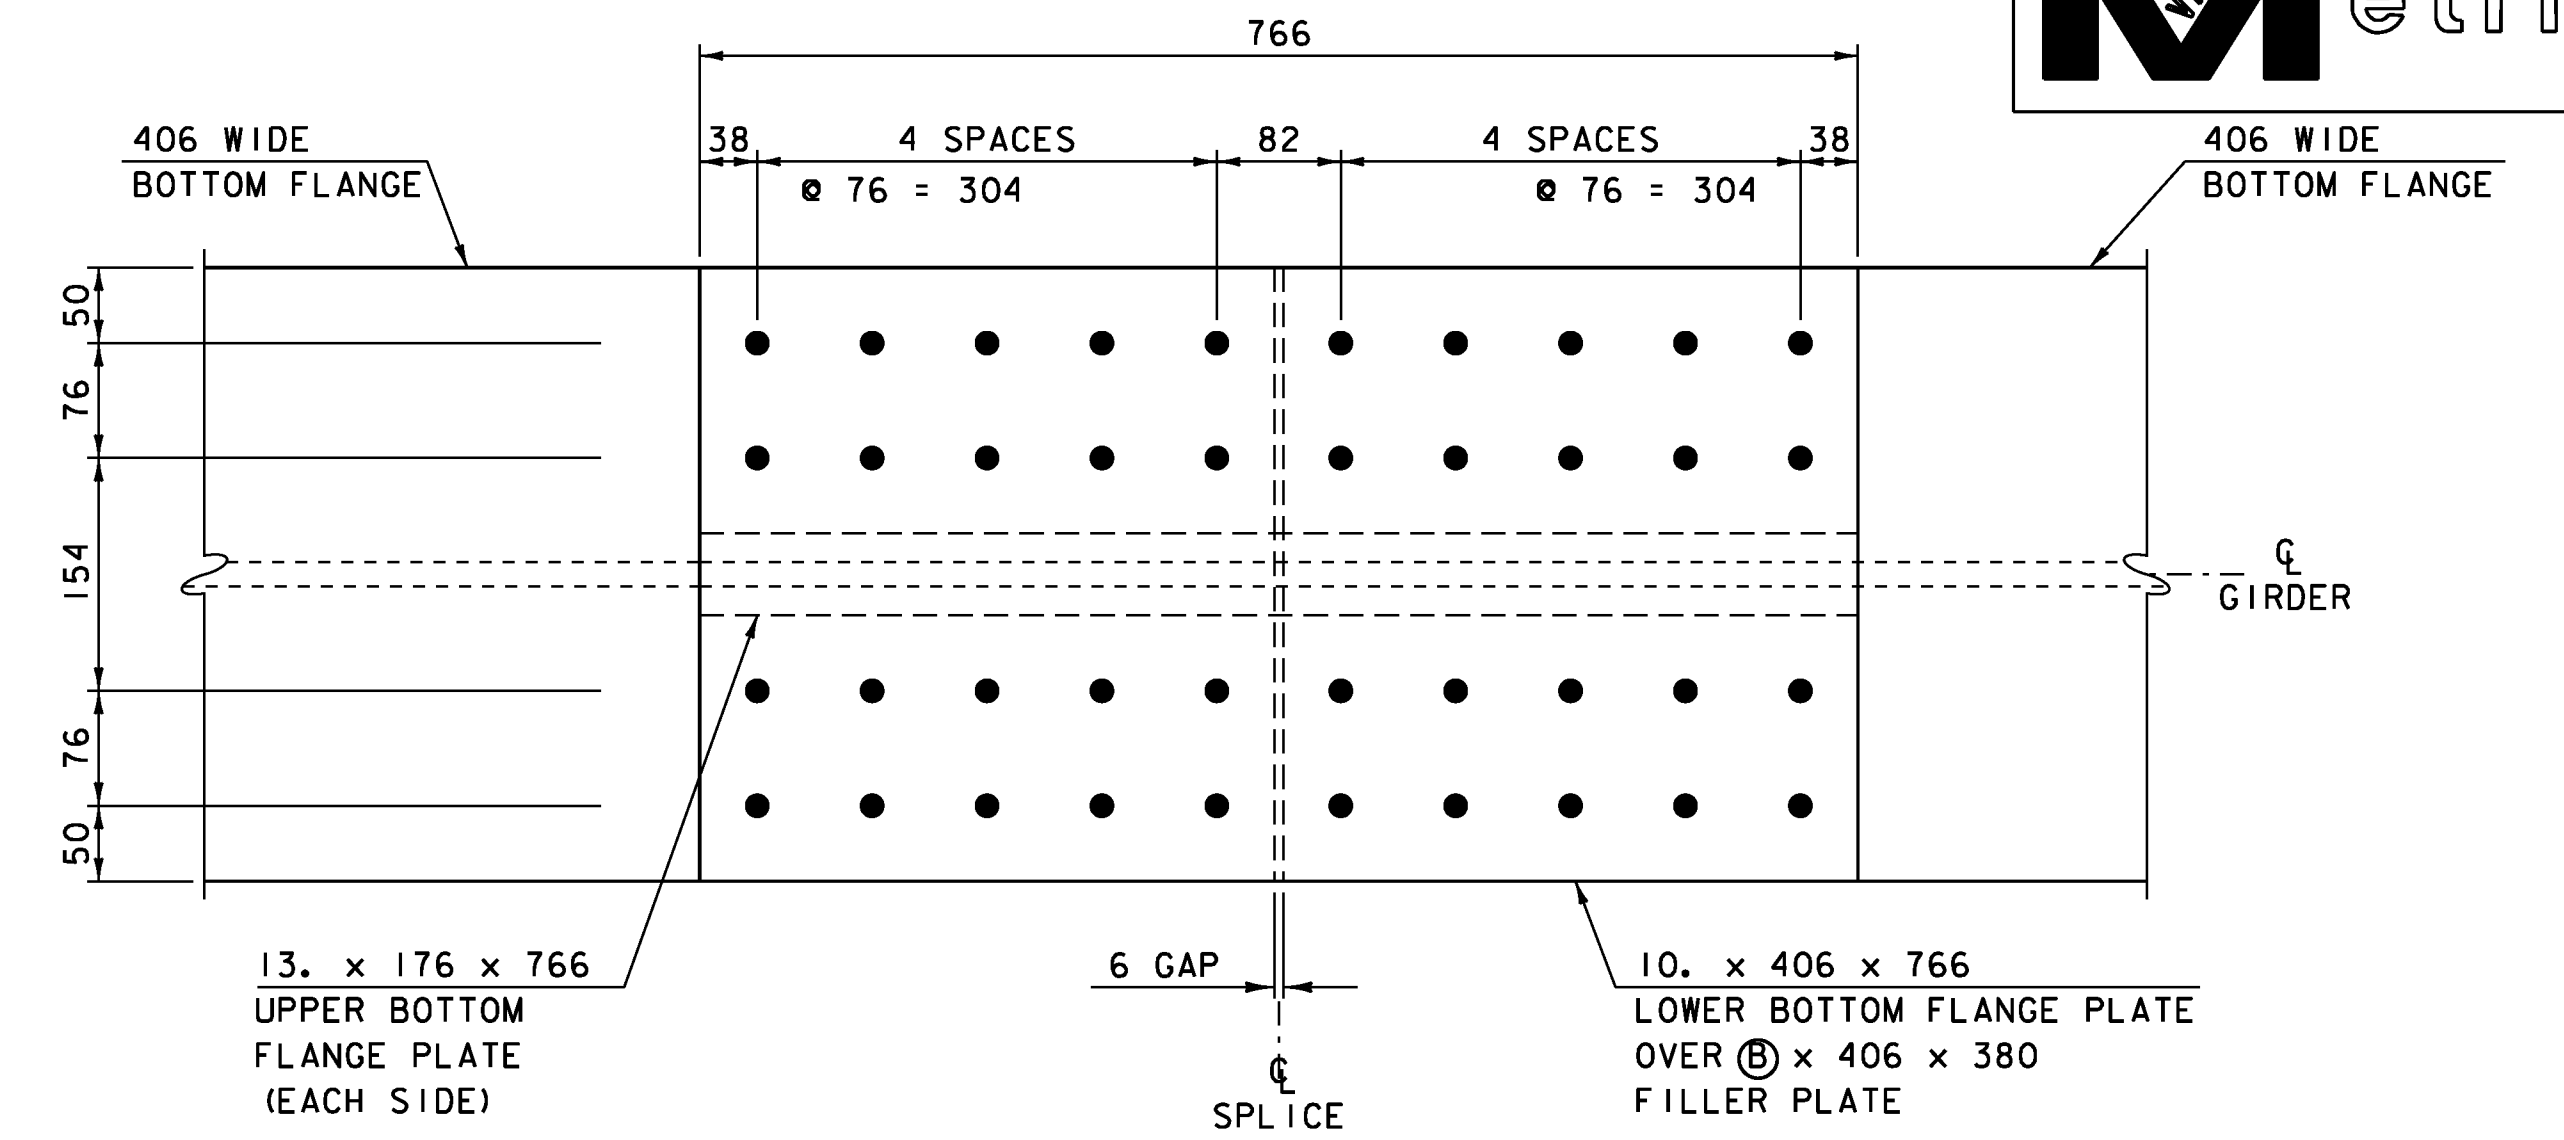


BOTTOM FLANGE PLAN

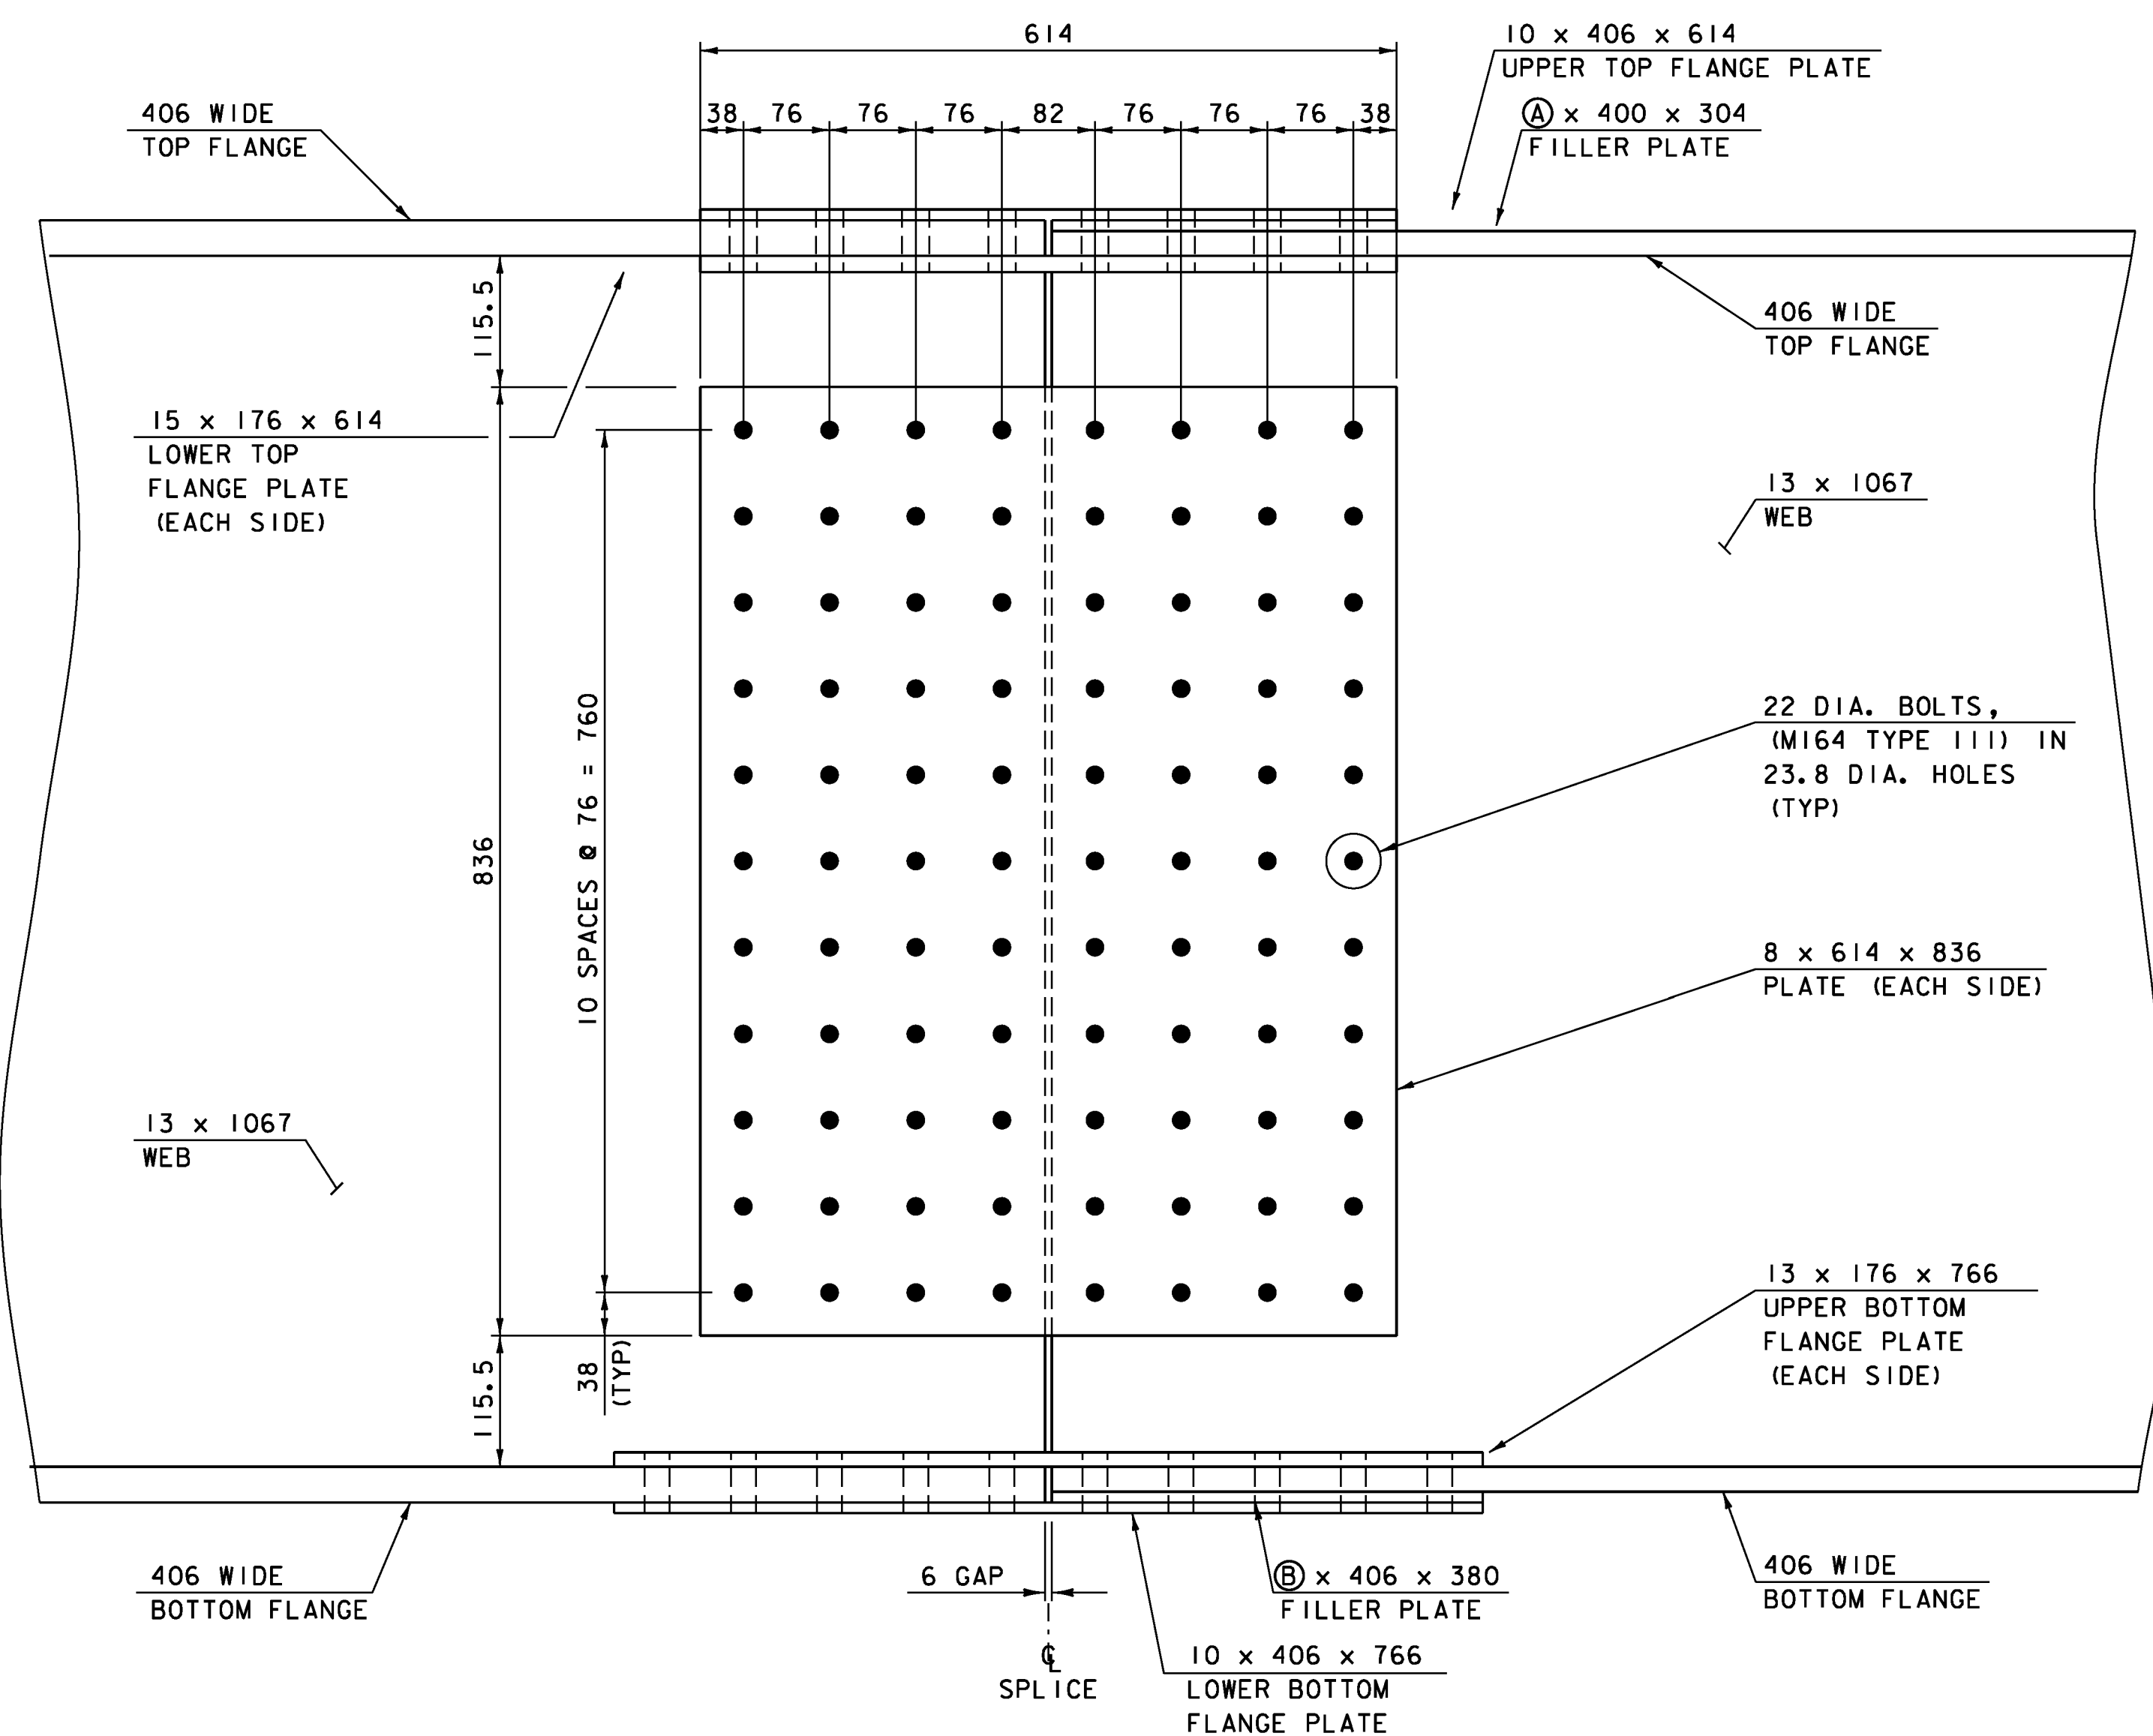

SPlice ELEVATION

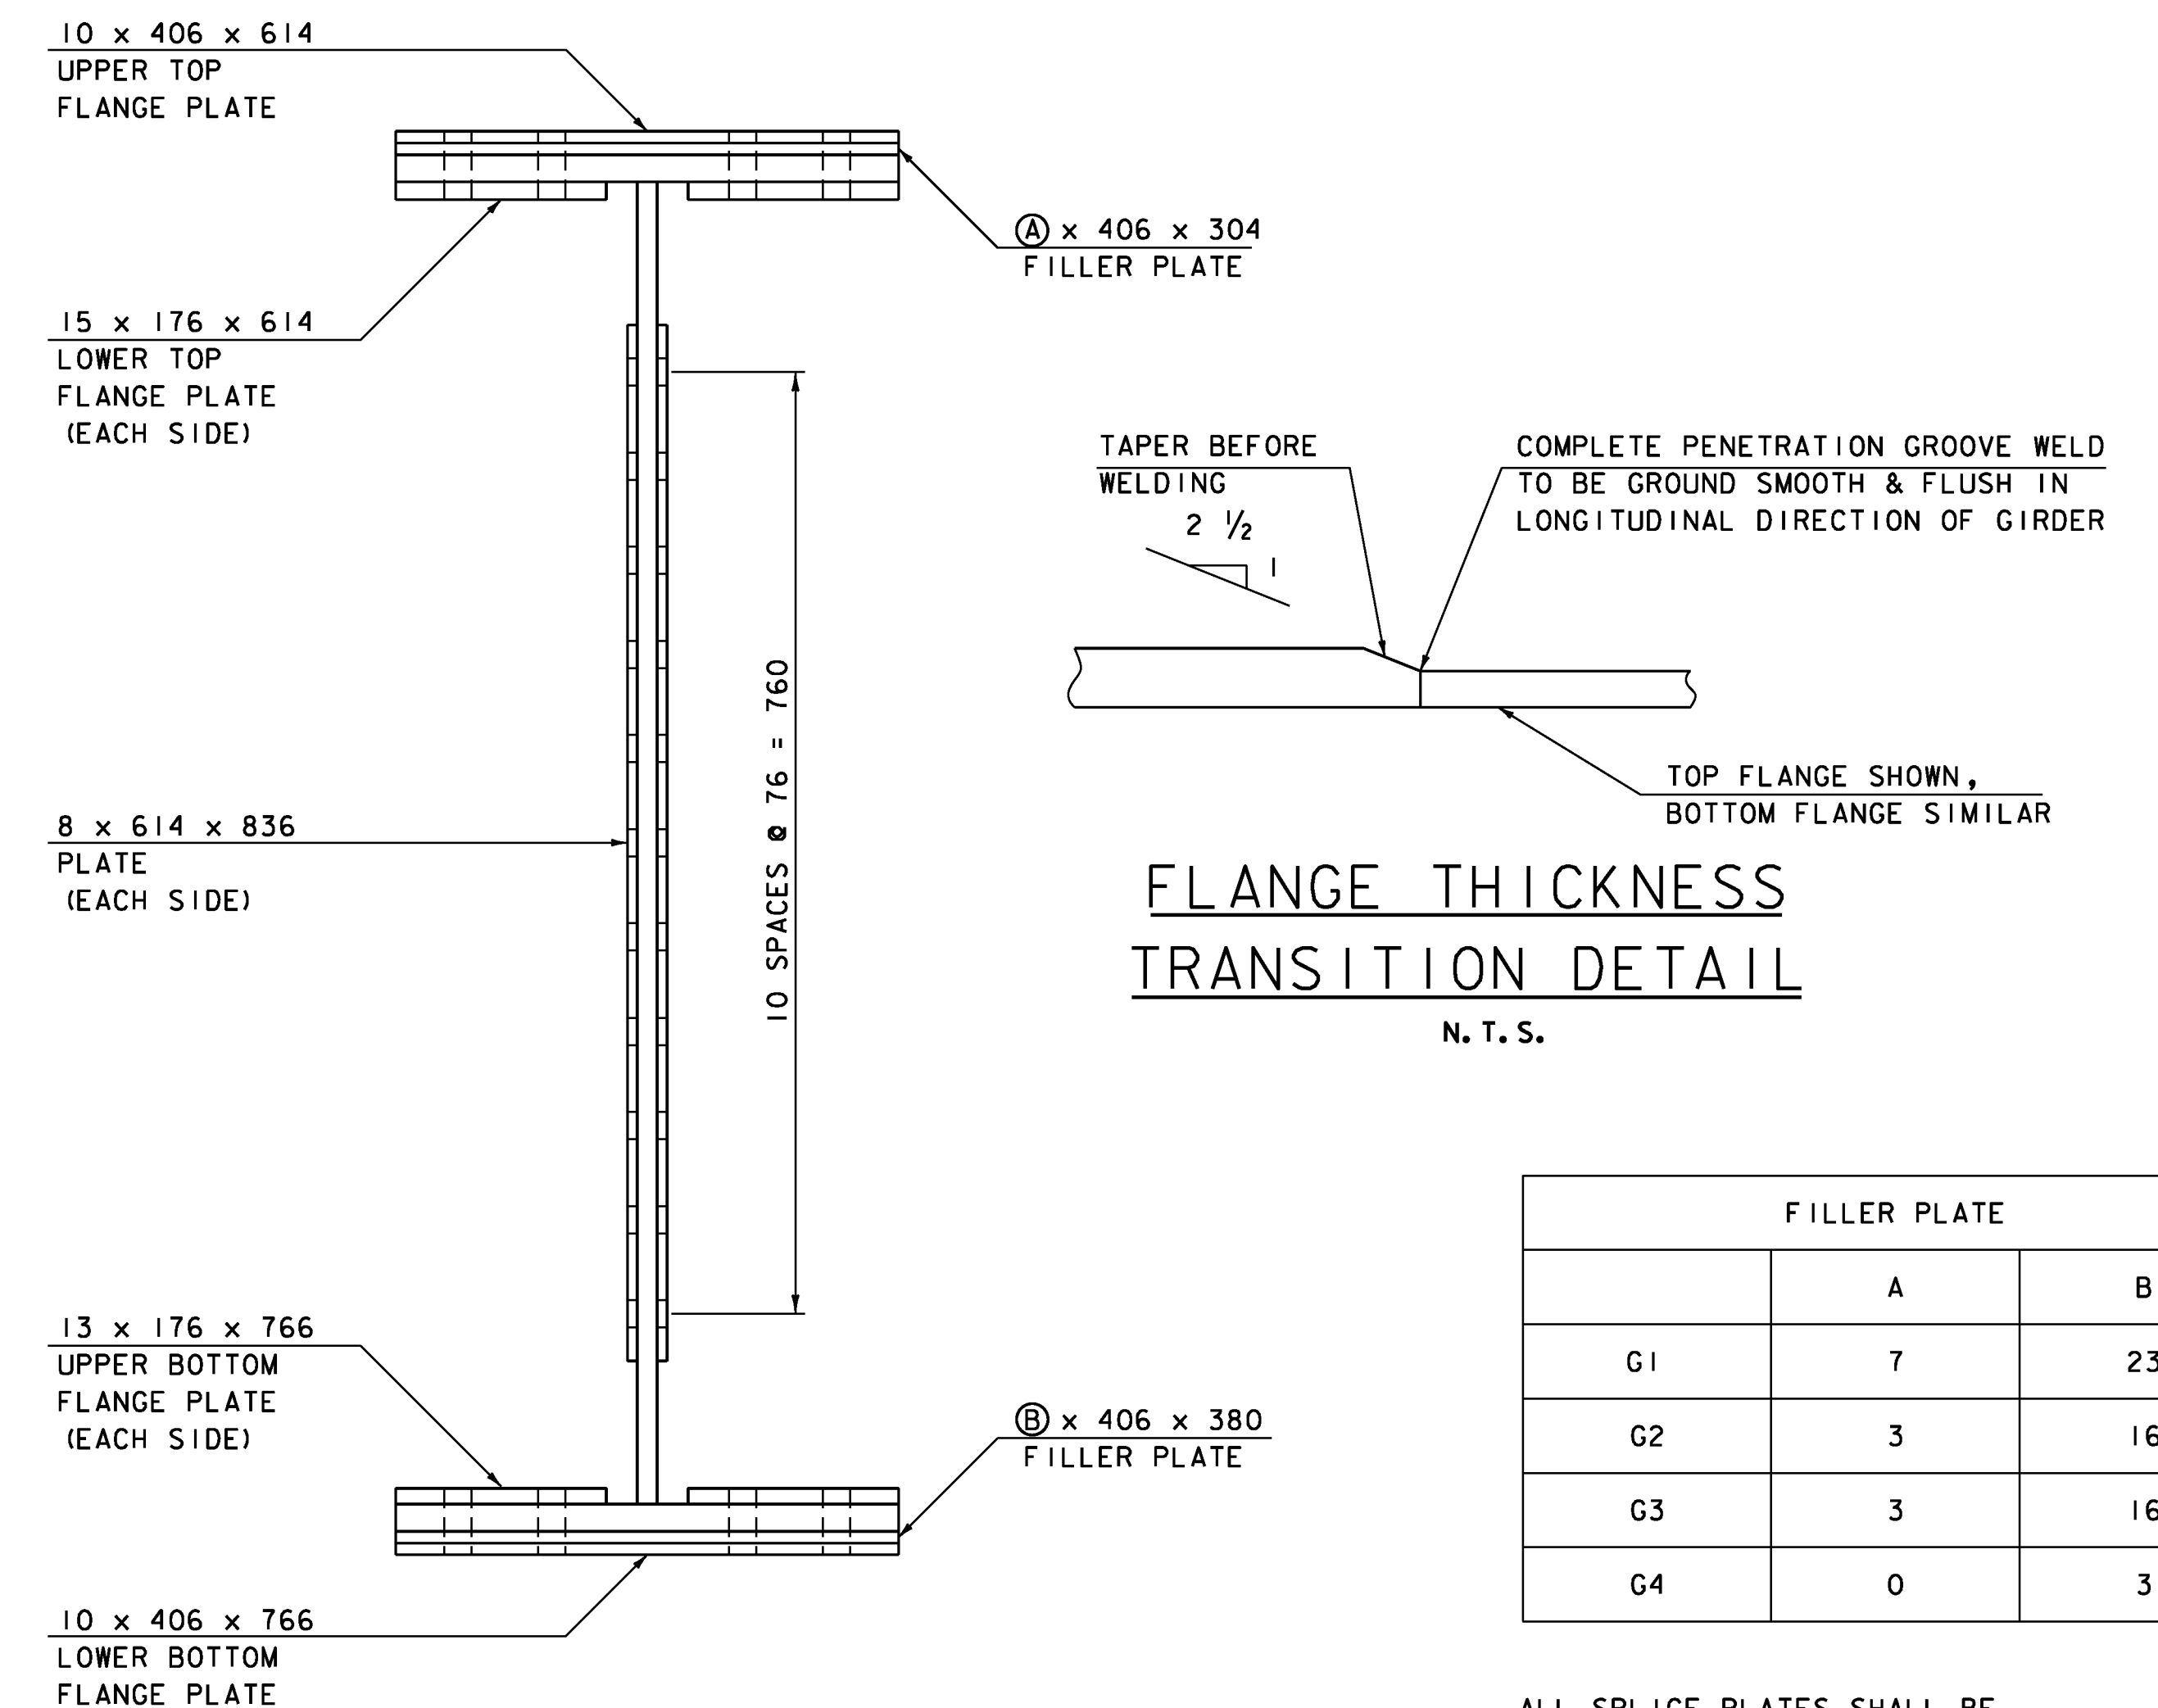

SPlice SECTION

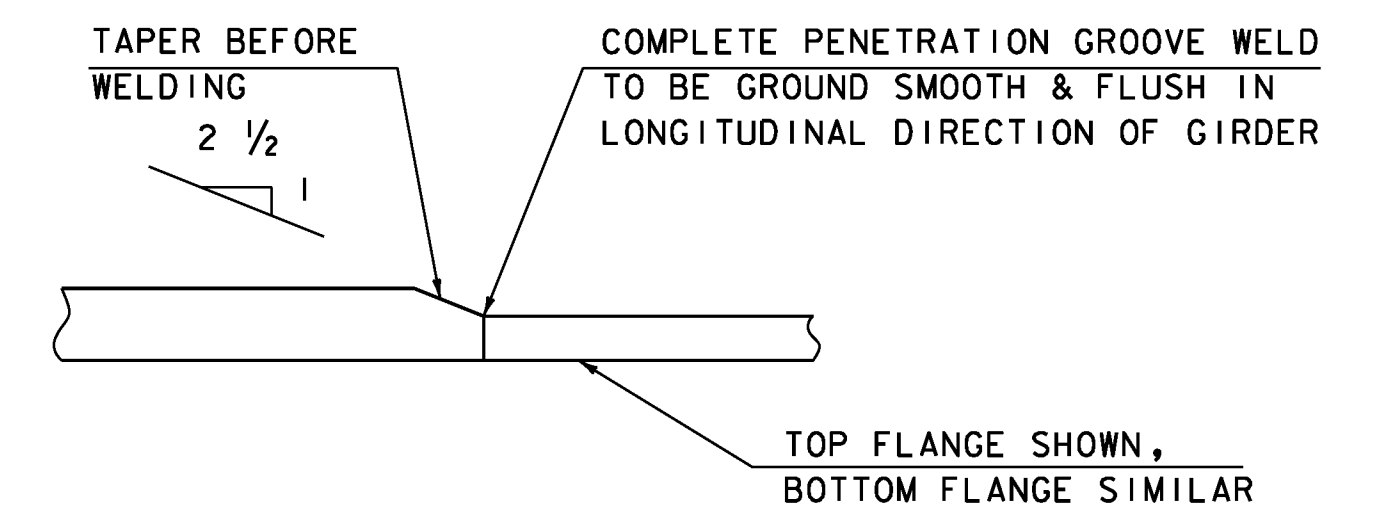


FLANGE THICKNESS TRANSITION DETAIL

N. T. S.

FILLER PLATE		
	A	B
G1	7	23
G2	3	16
G3	3	16
G4	0	3

ALL SPlice PLATES SHALL BE CVN (CHARPY V-NOTCH) TESTED, INCLUDING THE FILLER PLATES

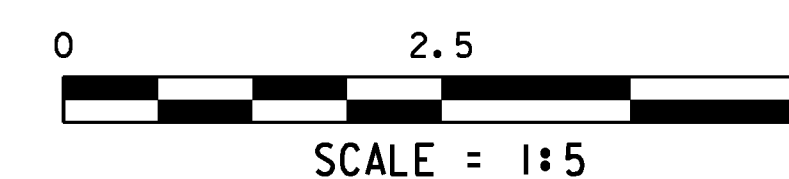

PROJECT NAME:	CAMBRIDGE	FILE NAME:	78f163super.dgn	PLOT DATE:	05-JUN-2012
PROJECT NUMBER:	BRF 027-1 (4)	PROJECT LEADER:	M. EVANS-MONGEON	DRAWN BY:	R. PELLETT
		DESIGNED BY:	T. FILLBACH	CHECKED BY:	T. FILLBACH
		SPlice DETAIL		SHEET	163 OF 214