

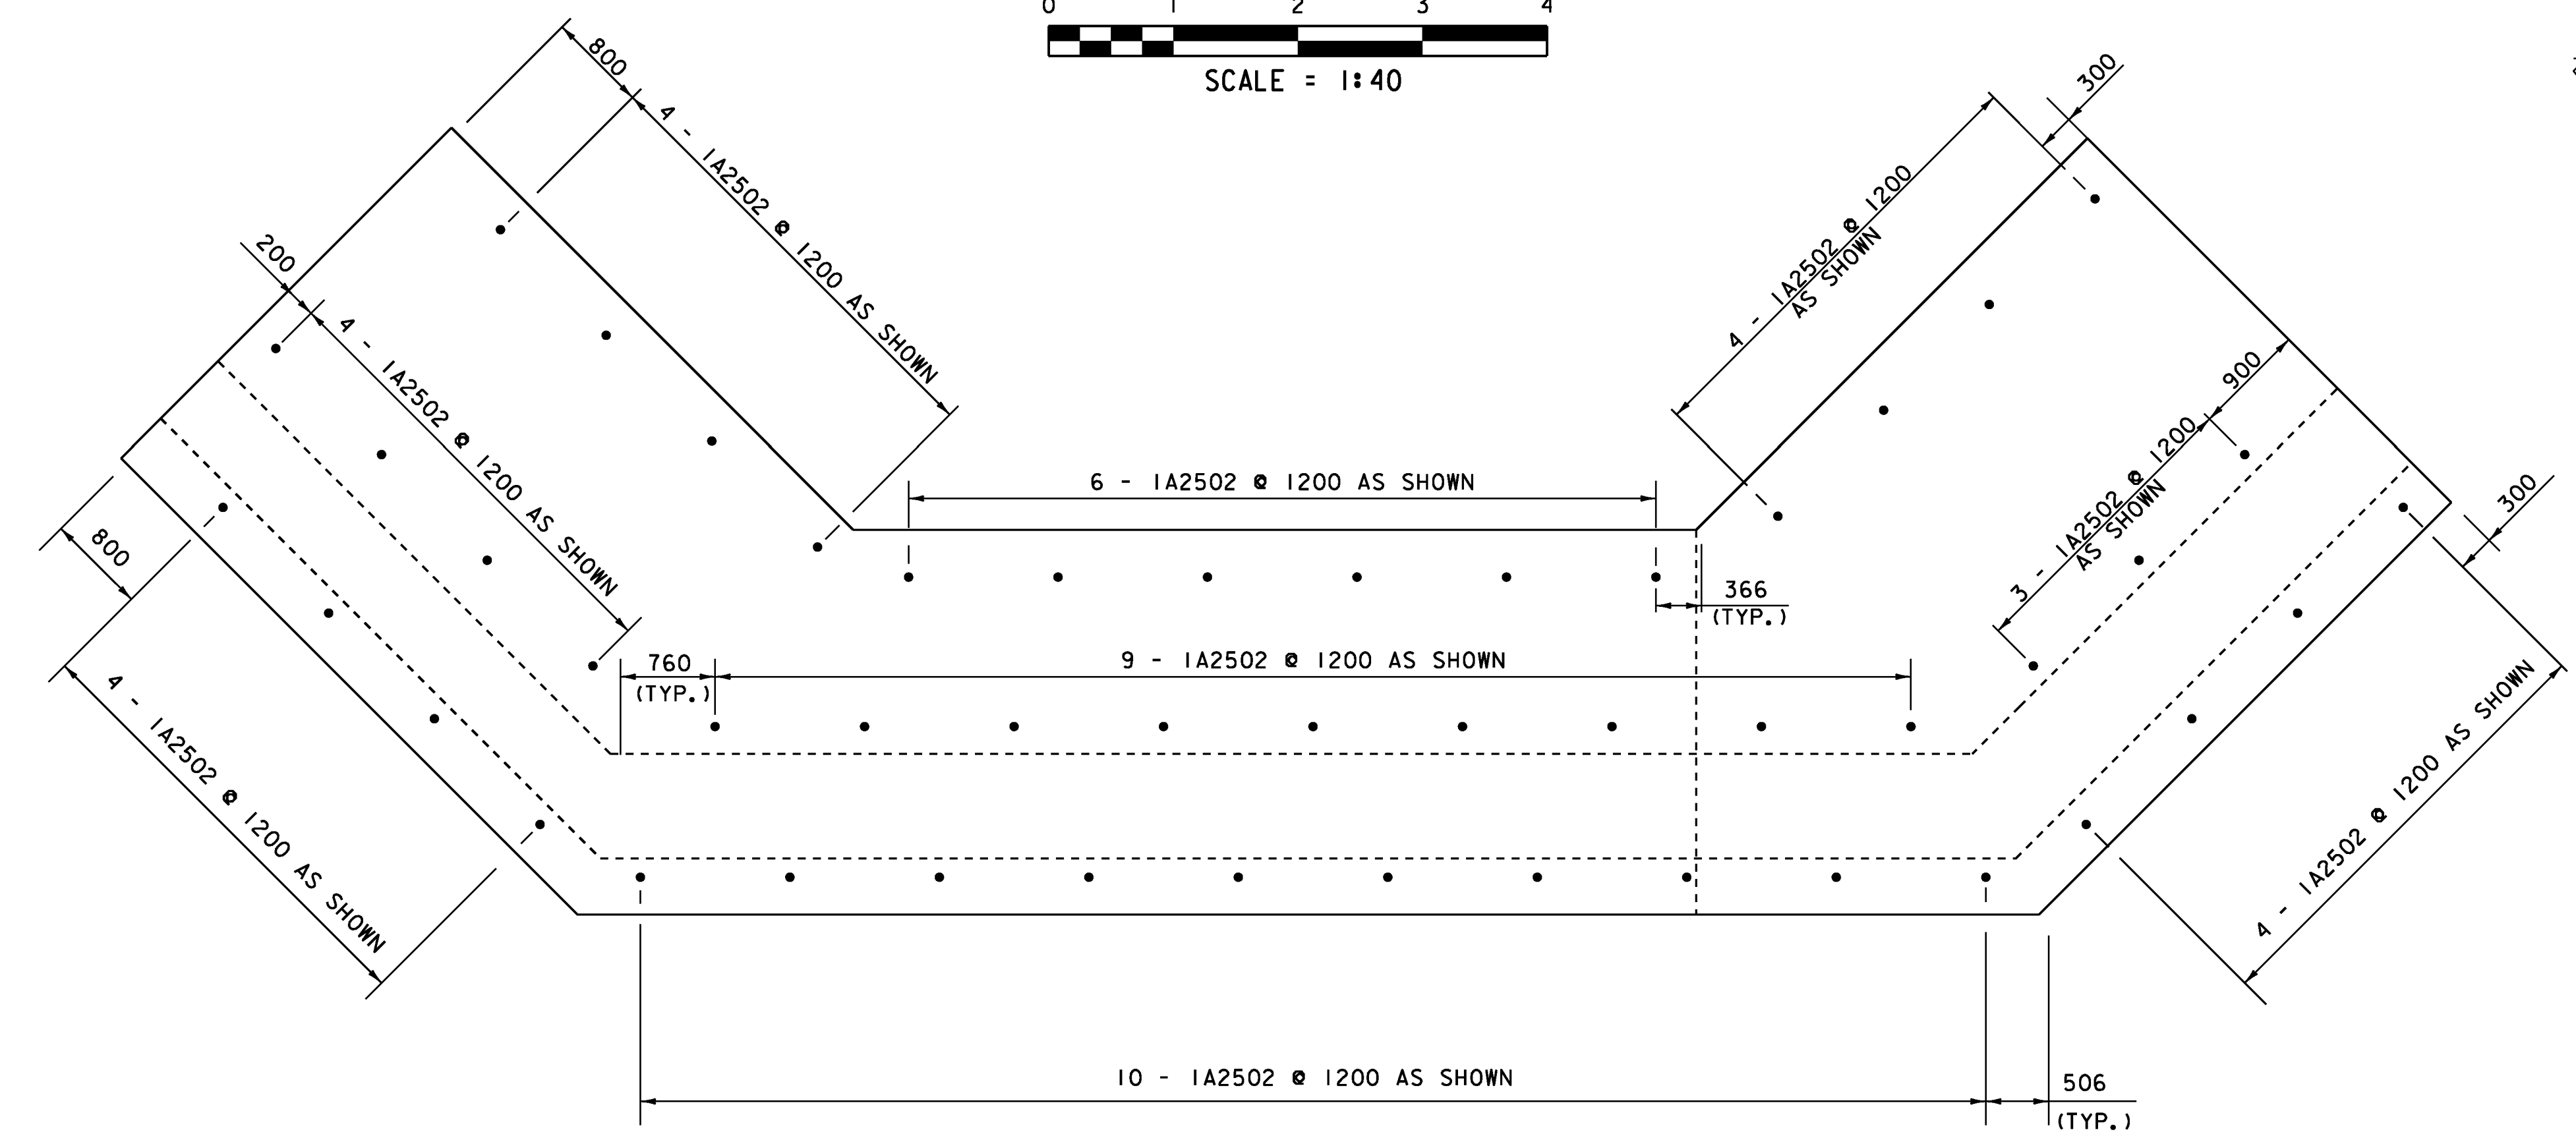
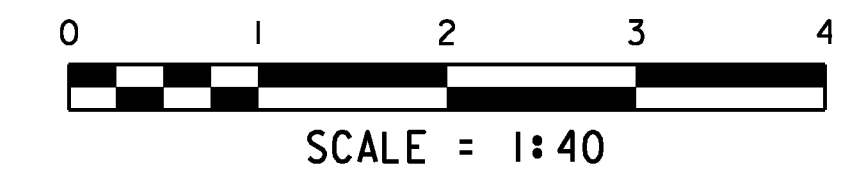



ABUTMENT #1 FOOTING REINFORCING PLAN

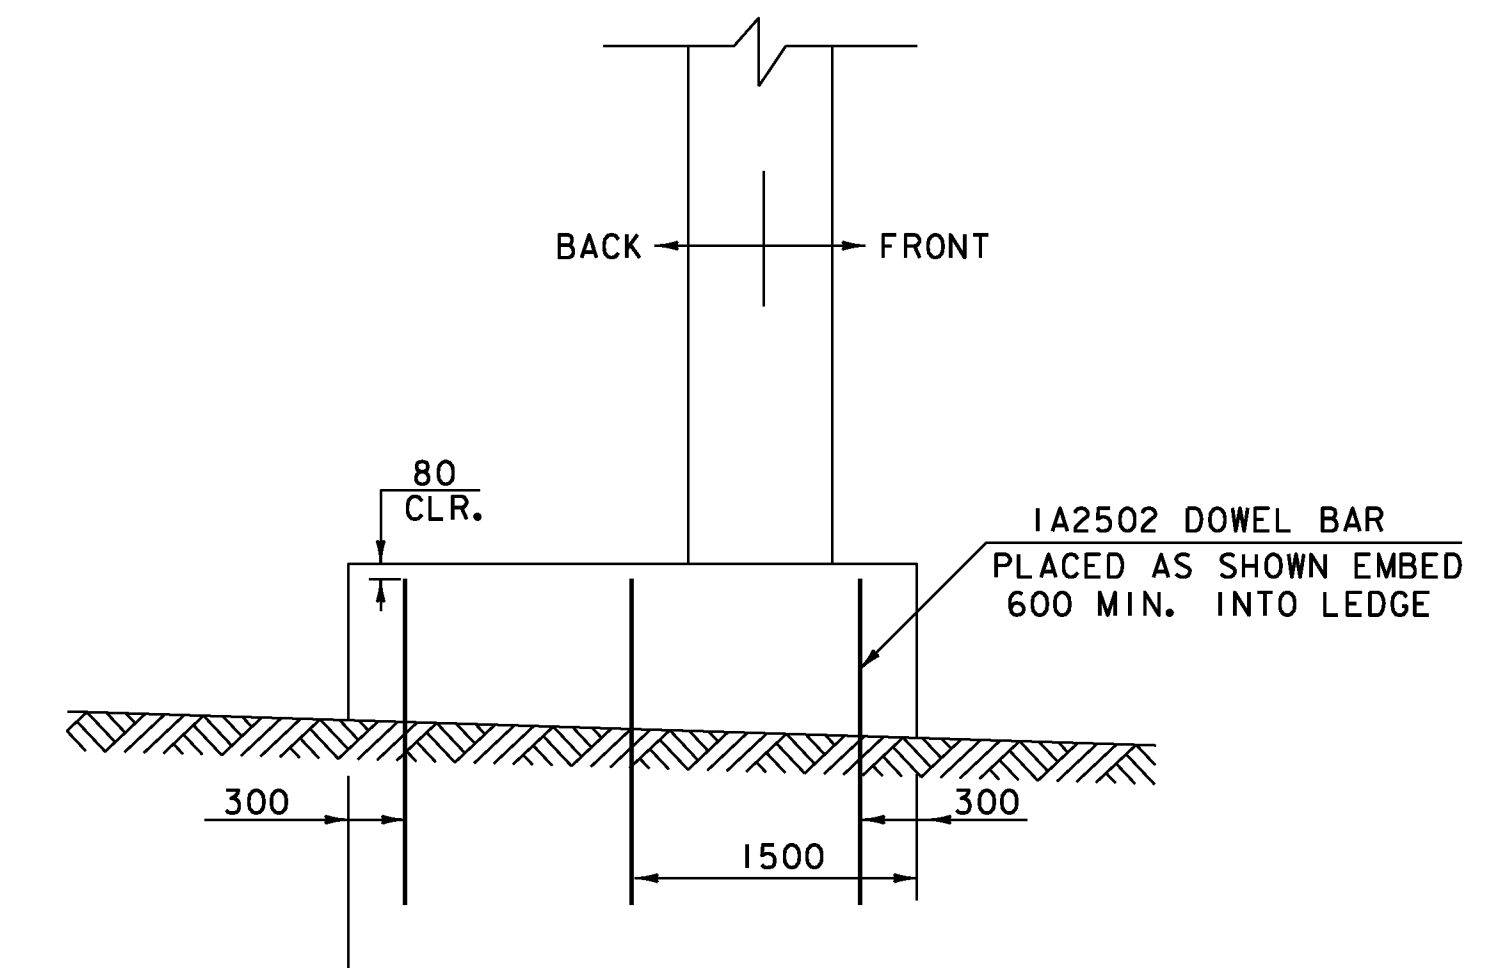

ABUTMENT #1 DOWEL PLAN

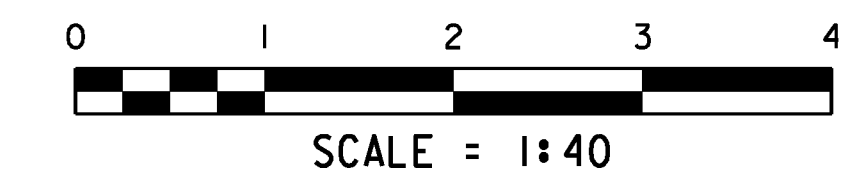

SUBSTRUCTURE FOOTING ANCHORAGE DETAIL

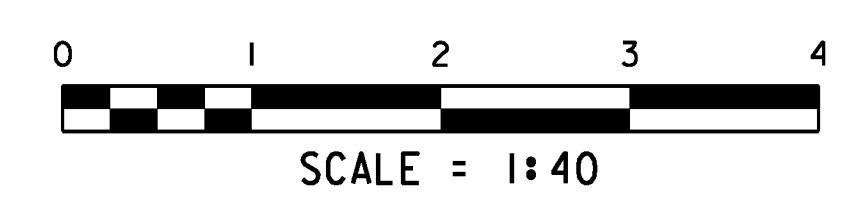

NOTE:
 NF = NEAR FACE
 FF = FAR FACE
 EF = EACH FACE
 ▲ = CUT TO FIT IN FIELD
 80 CLEAR, UNLESS OTHERWISE SPECIFIED ON THE PLANS.
 660 BAR LAP UNLESS OTHERWISE SPECIFIED ON THE PLANS.

PROJECT NAME:	CAMBRIDGE	
PROJECT NUMBER:	BRF 027-1 (4)	
FILE NAME:	78f163subst.dgn	PLOT DATE: 05-JUN-2012
PROJECT LEADER:	M. EVANS-MONGEON	DRAWN BY: R. PELLETT
DESIGNED BY:	T. FILLBACH	CHECKED BY: T. FILLBACH
ABUTMENT #1 SHEET 3		SHEET 174 OF 214