

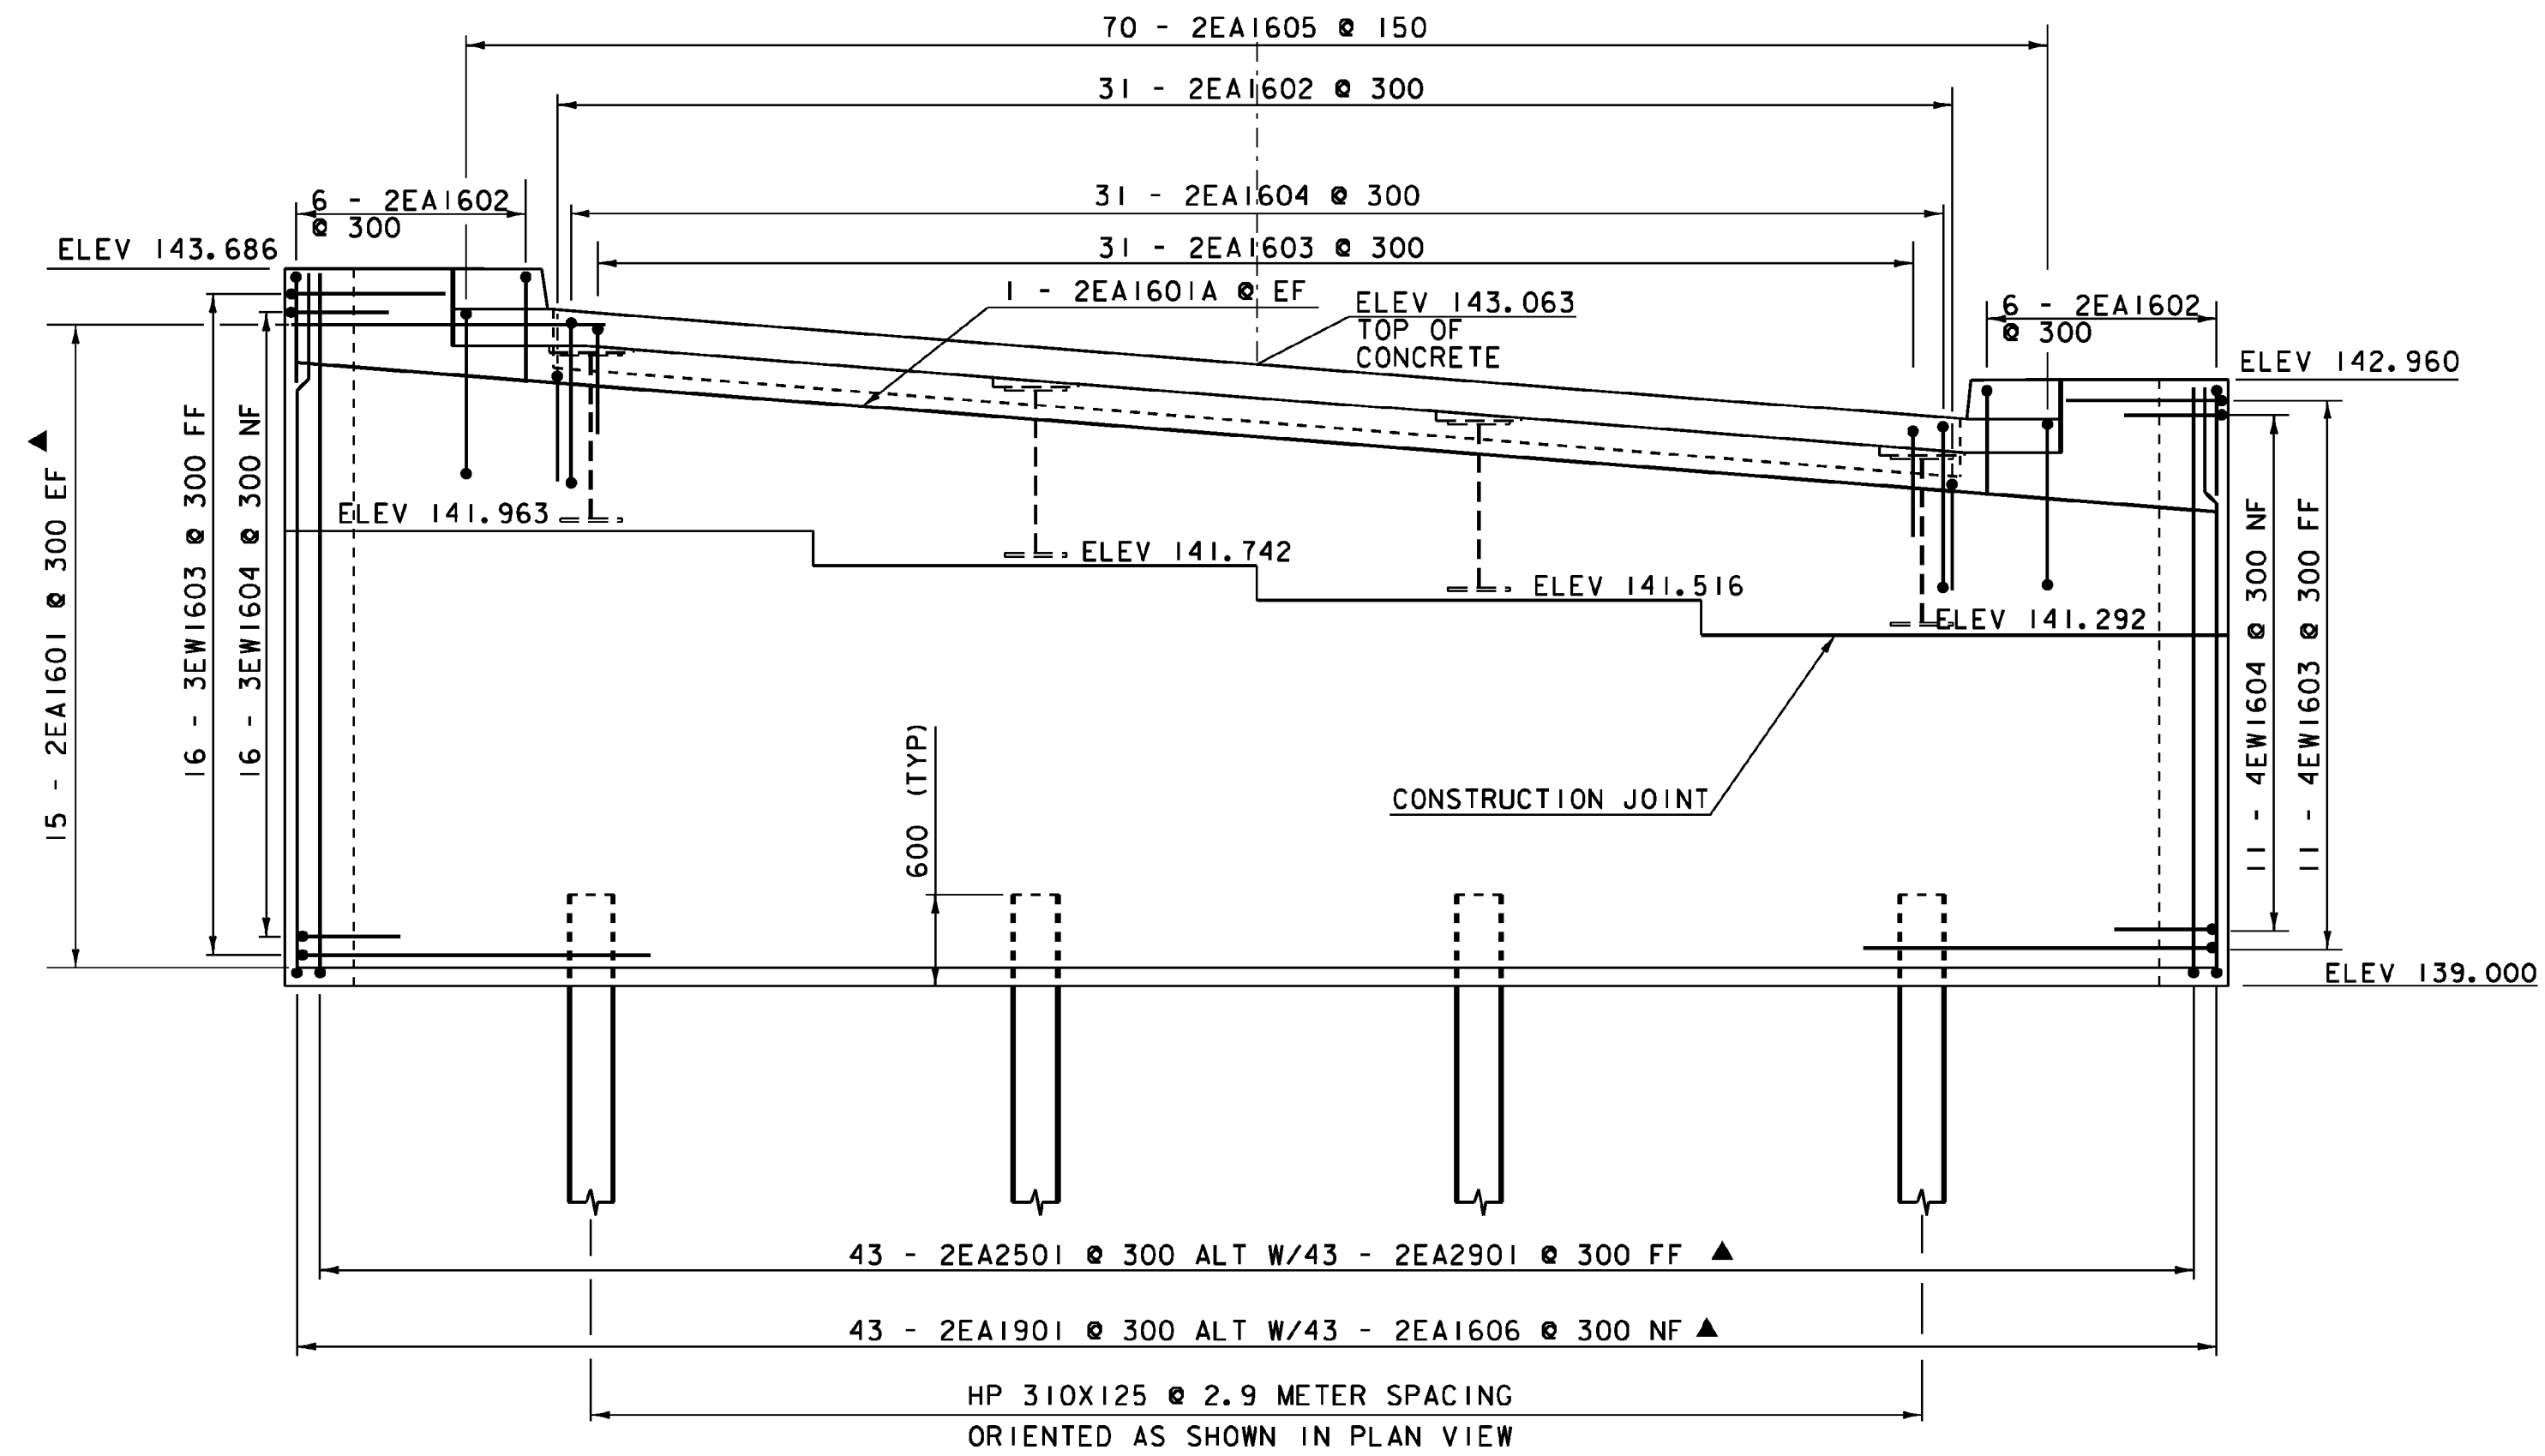



ABUTMENT #2 PLAN

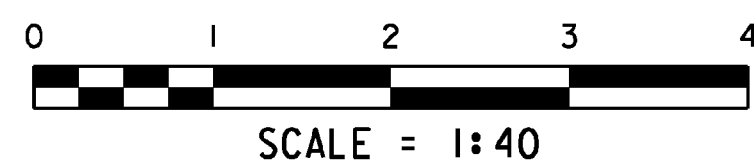


ABUTMENT #2 ELEVATION

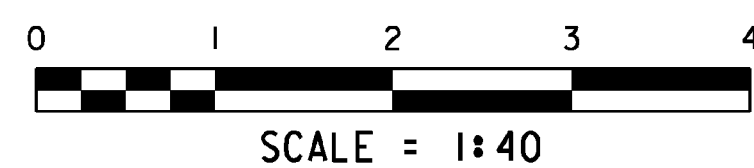

* PLUG JOINTING MOVED TO END OF APPROACH SLAB STA. 10+256.250
HOT POURED JOINT USED AT END OF BRIDGE

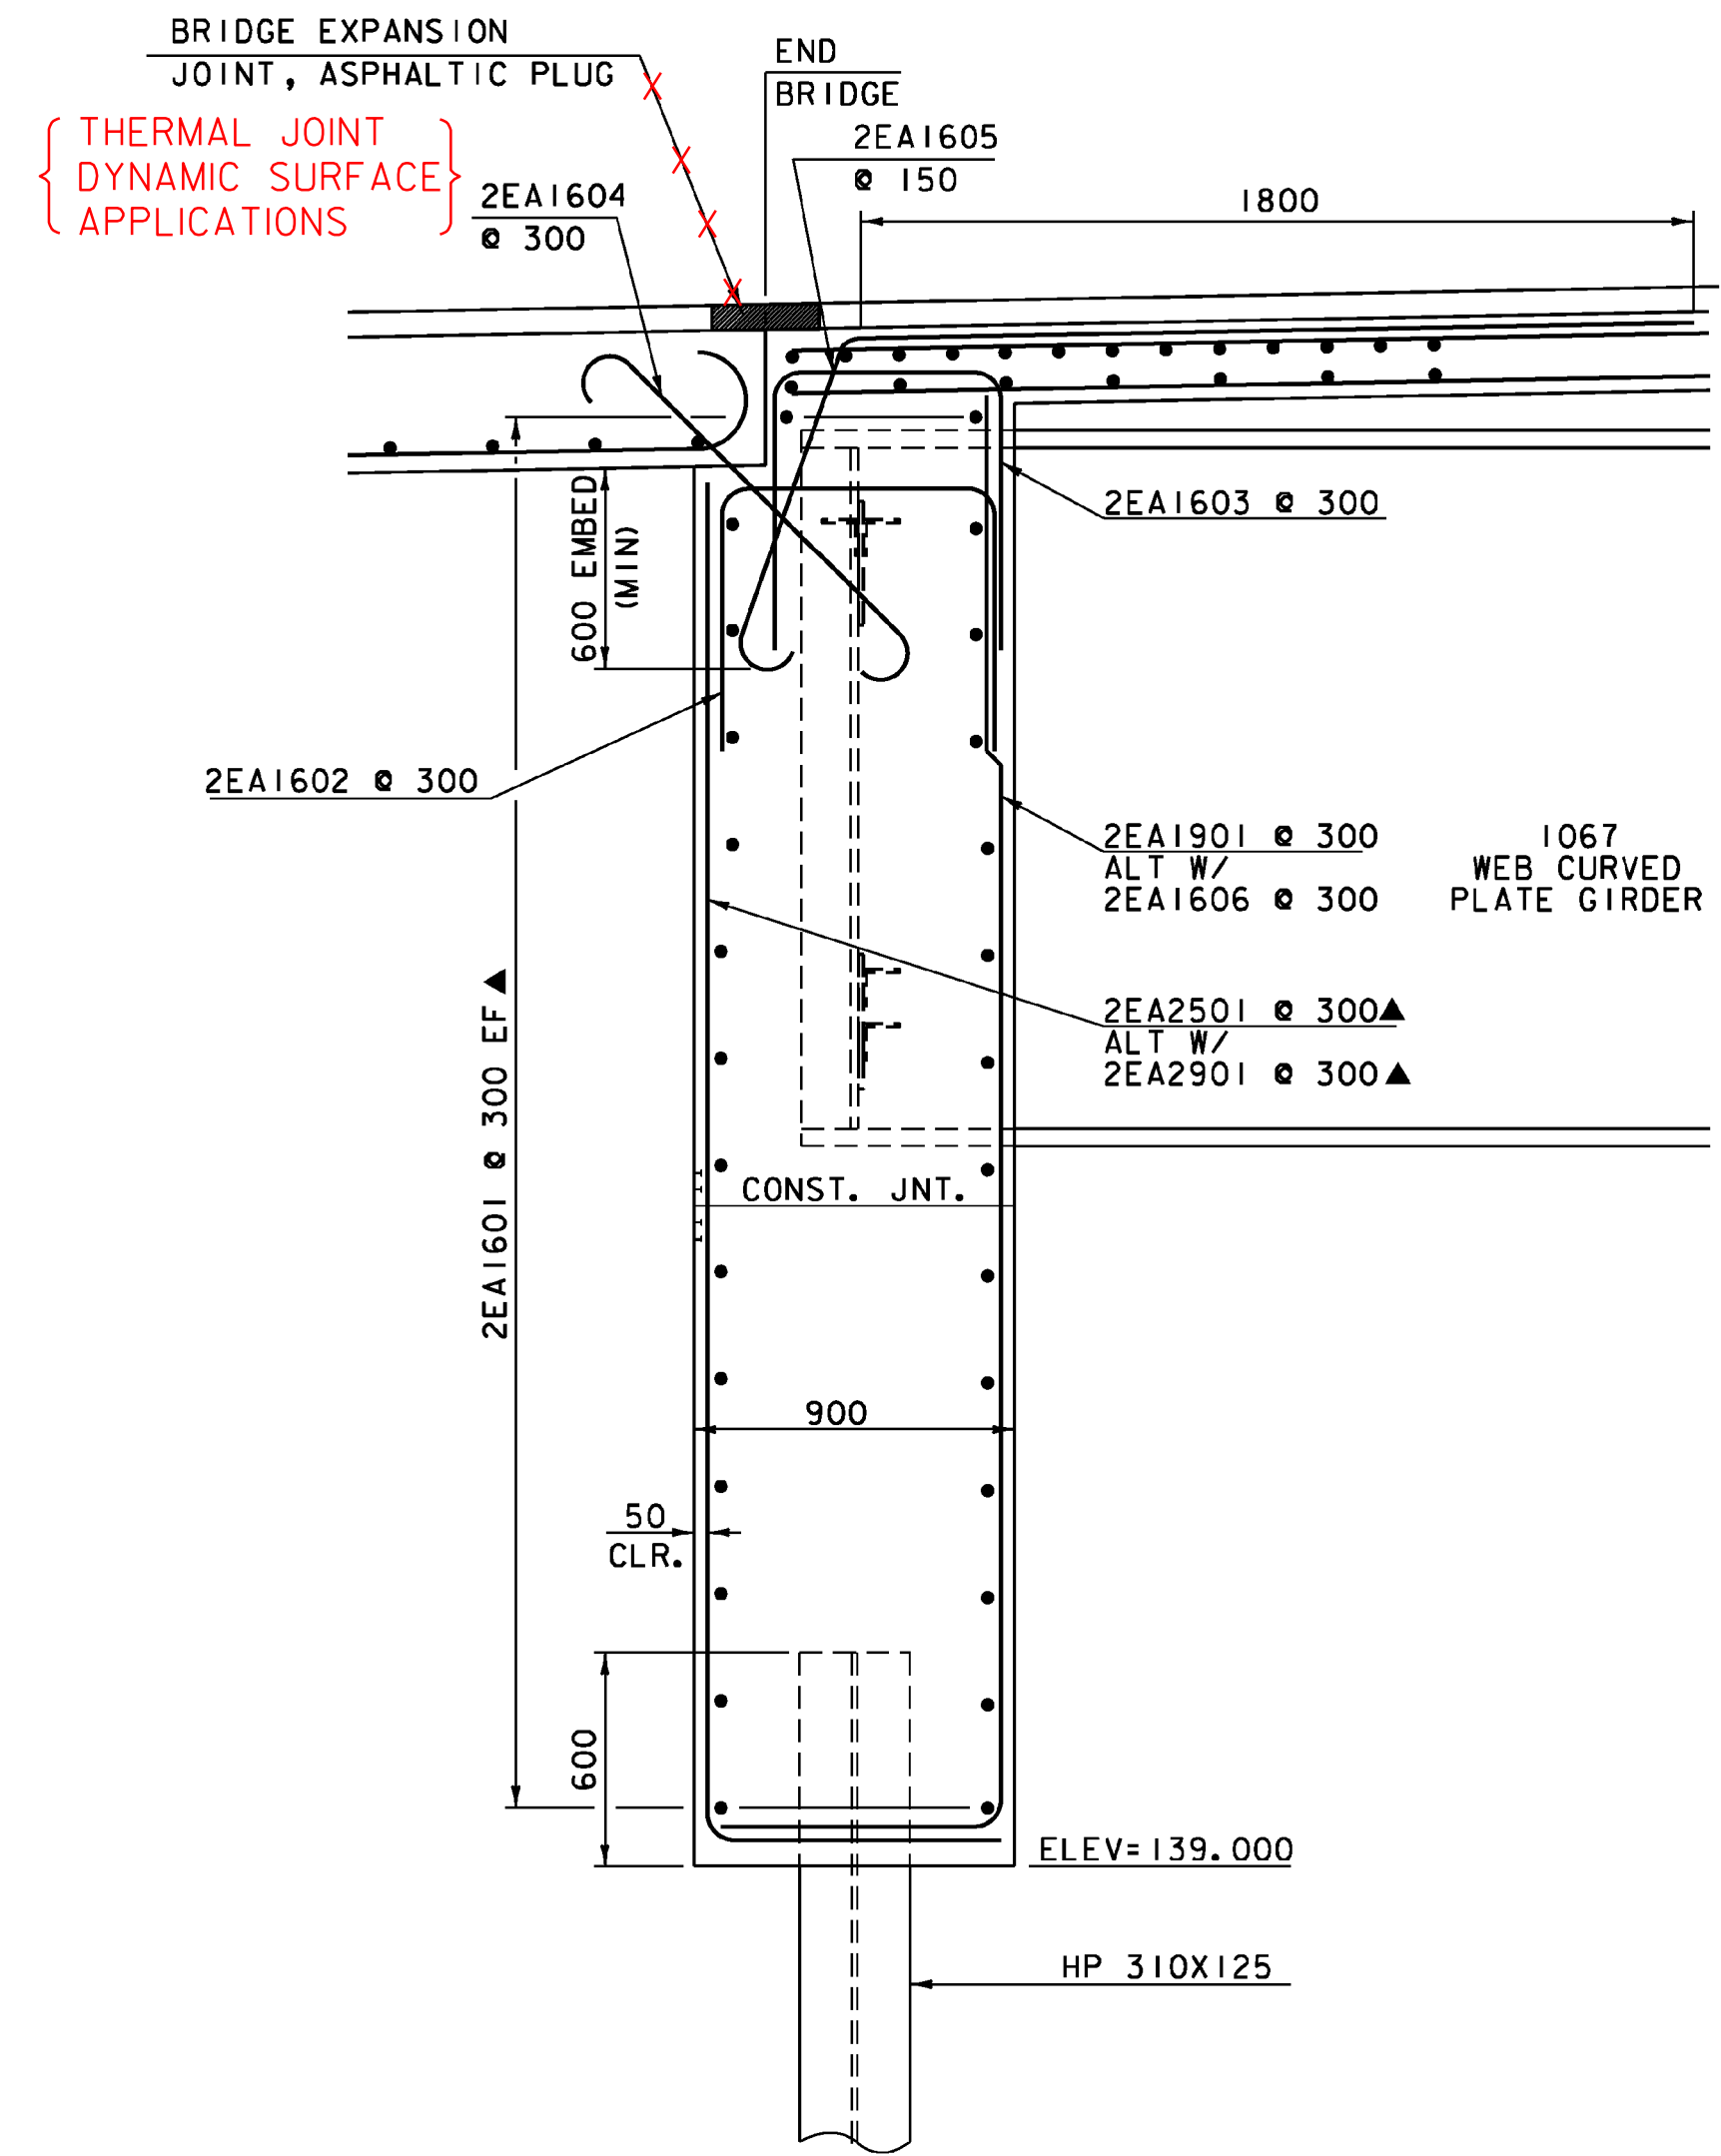

BRIDGE END DETAIL AND ABUTMENT #2 TYPICAL SECTION

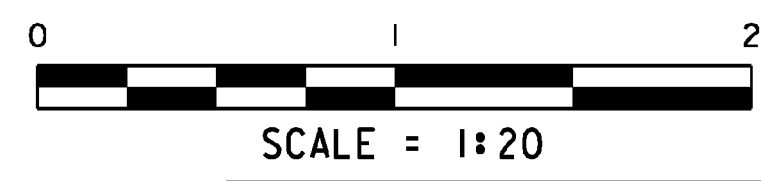

NOTE:
 NF = NEAR FACE
 FF = FAR FACE
 EF = EACH FACE
 = CUT TO FIT IN FIELD
 80 CLEAR, UNLESS OTHERWISE SPECIFIED ON THE PLANS.
 ▲ 660 BAR LAP UNLESS OTHERWISE SPECIFIED ON THE PLANS.

PROJECT NAME:	CAMBRIDGE	
PROJECT NUMBER:	BRF 027-1 (4)	
FILE NAME:	78f163subst.dgn	PLOT DATE: 05-JUN-2012
PROJECT LEADER:	M. EVANS-MONGEON	DRAWN BY: R. PELLETT
DESIGNED BY:	T. FILLBACH	CHECKED BY: T. FILLBACH
ABUTMENT #2		SHEET 179 OF 214