


10+120.0



10+100.0  
DRIVE RIGHT

10+082.794 BEGIN PROJECT

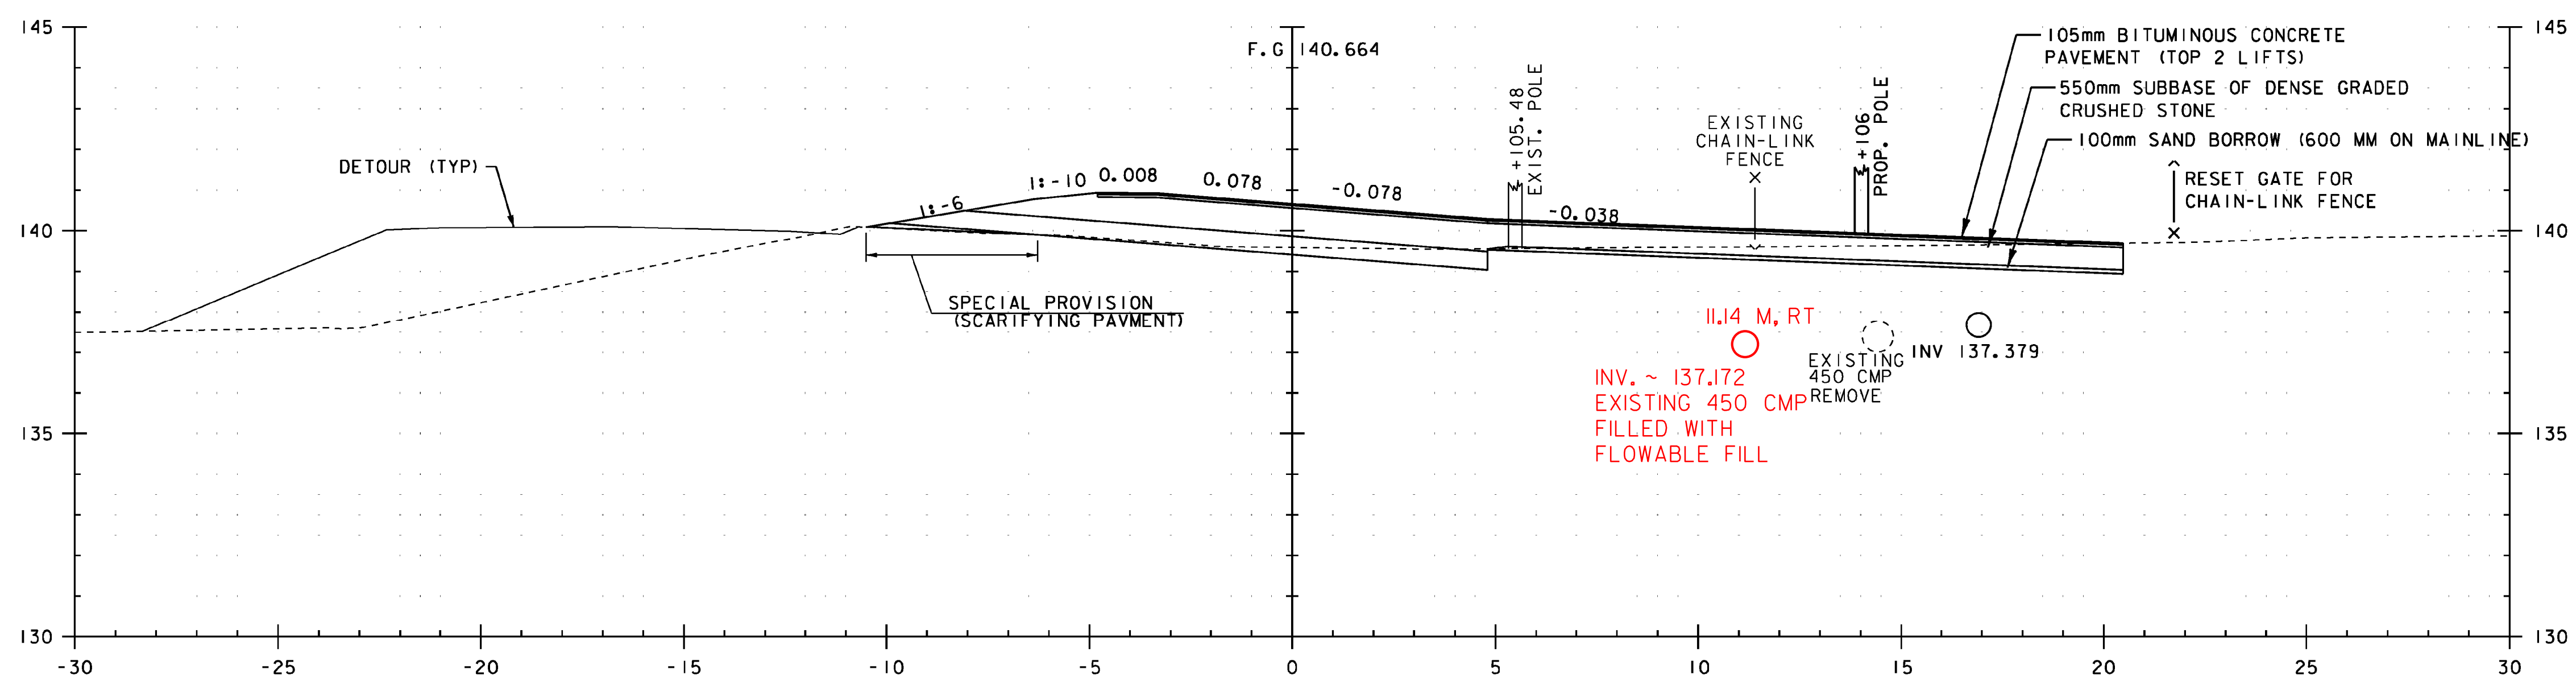

STA 10+100.0 TO STA 10+120.0

PROJECT NAME: CAMBRIDGE	PLOT DATE: 05-JUN-2012
PROJECT NUMBER: BRF 027-1 (4)	DRAWN BY: G. ROKES
FILE NAME: s78f163xs1dgn	CHECKED BY: S. SCRIBNER
PROJECT LEADER: M. EVANS-MONGEON	SHEET 188 OF 214
DESIGNED BY: EVANS-MONGEON	
VT 108 - CROSS SECTION 1	