


10+160.0



10+140.0

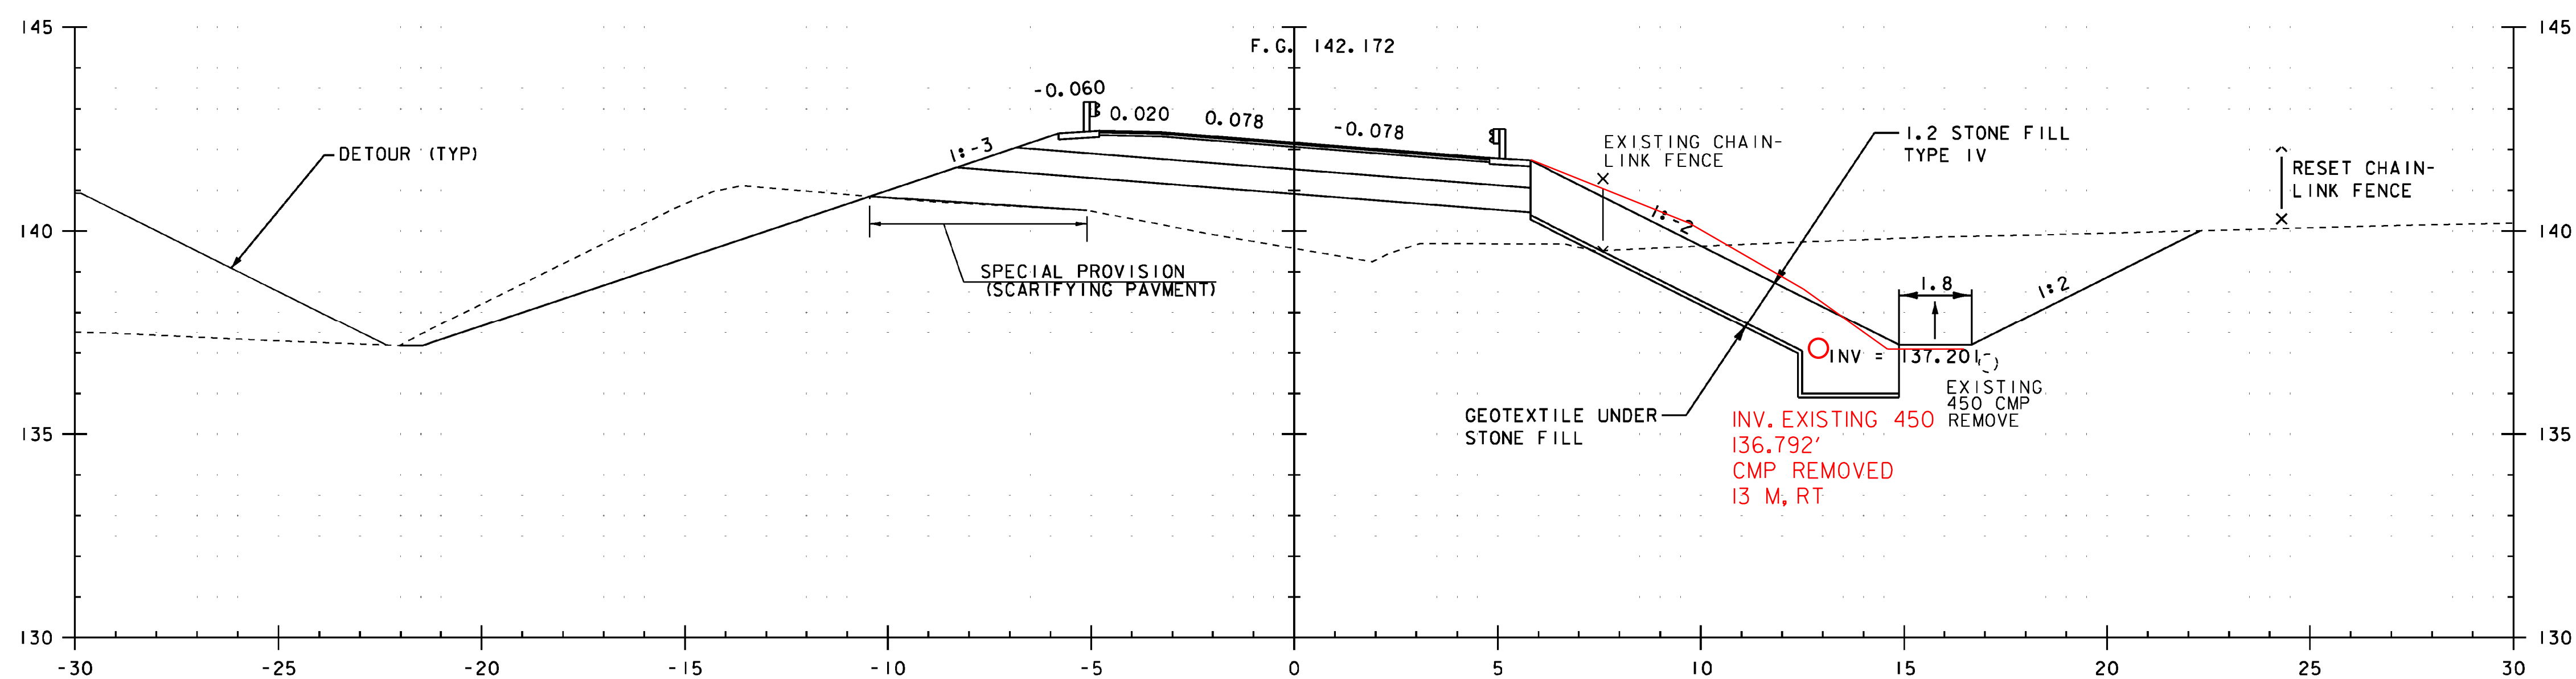

FROM STA 10+140.0 TO STA 10+160.0

PROJECT NAME:	CAMBRIDGE	PLOT DATE:	05-JUN-2012
PROJECT NUMBER:	BRF 027-1 (4)	DRAWN BY:	G. ROKES
FILE NAME:	s78f163xs1dgn	DESIGNED BY:	EVANS-MONGEON
PROJECT LEADER:	M. EVANS-MONGEON	CHECKED BY:	S. SCRIBNER
VT 108 - CROSS SECTION 2		SHEET	189 OF 214