


50+070.000

**STA 50+070.000**

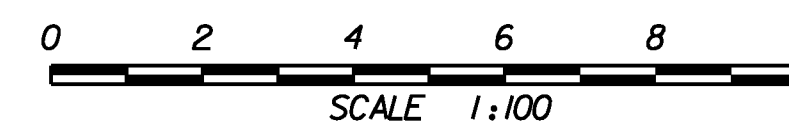

PROJECT NAME: CAMBRIDGE	PLOT DATE: 05-JUN-2012
PROJECT NUMBER: BRF 027-I(4)	DRAWN BY: EVANS-MONGEON
FILE NAME: s78f163chxs.dgn	CHECKED BY: S. SCRIBNER
PROJECT LEADER: M. EVANS-MONGEON	SHEET 203 OF 214
DESIGNED BY: T. FILBACH	
CHANNEL SECTION 3	