


50+090.000

STA 50+090.000

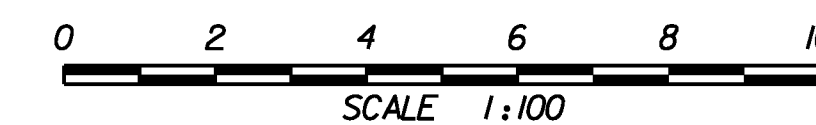

PROJECT NAME: CAMBRIDGE	PLOT DATE: 05-JUN-2012
PROJECT NUMBER: BRF 027-I(4)	DRAWN BY: EVANS-MONGEON
FILE NAME: s78f163chxs.dgn	CHECKED BY: S. SCRIBNER
DESIGNED BY: T. FILBACH	SHEET 207 OF 214
CHANNEL SECTION 7	