
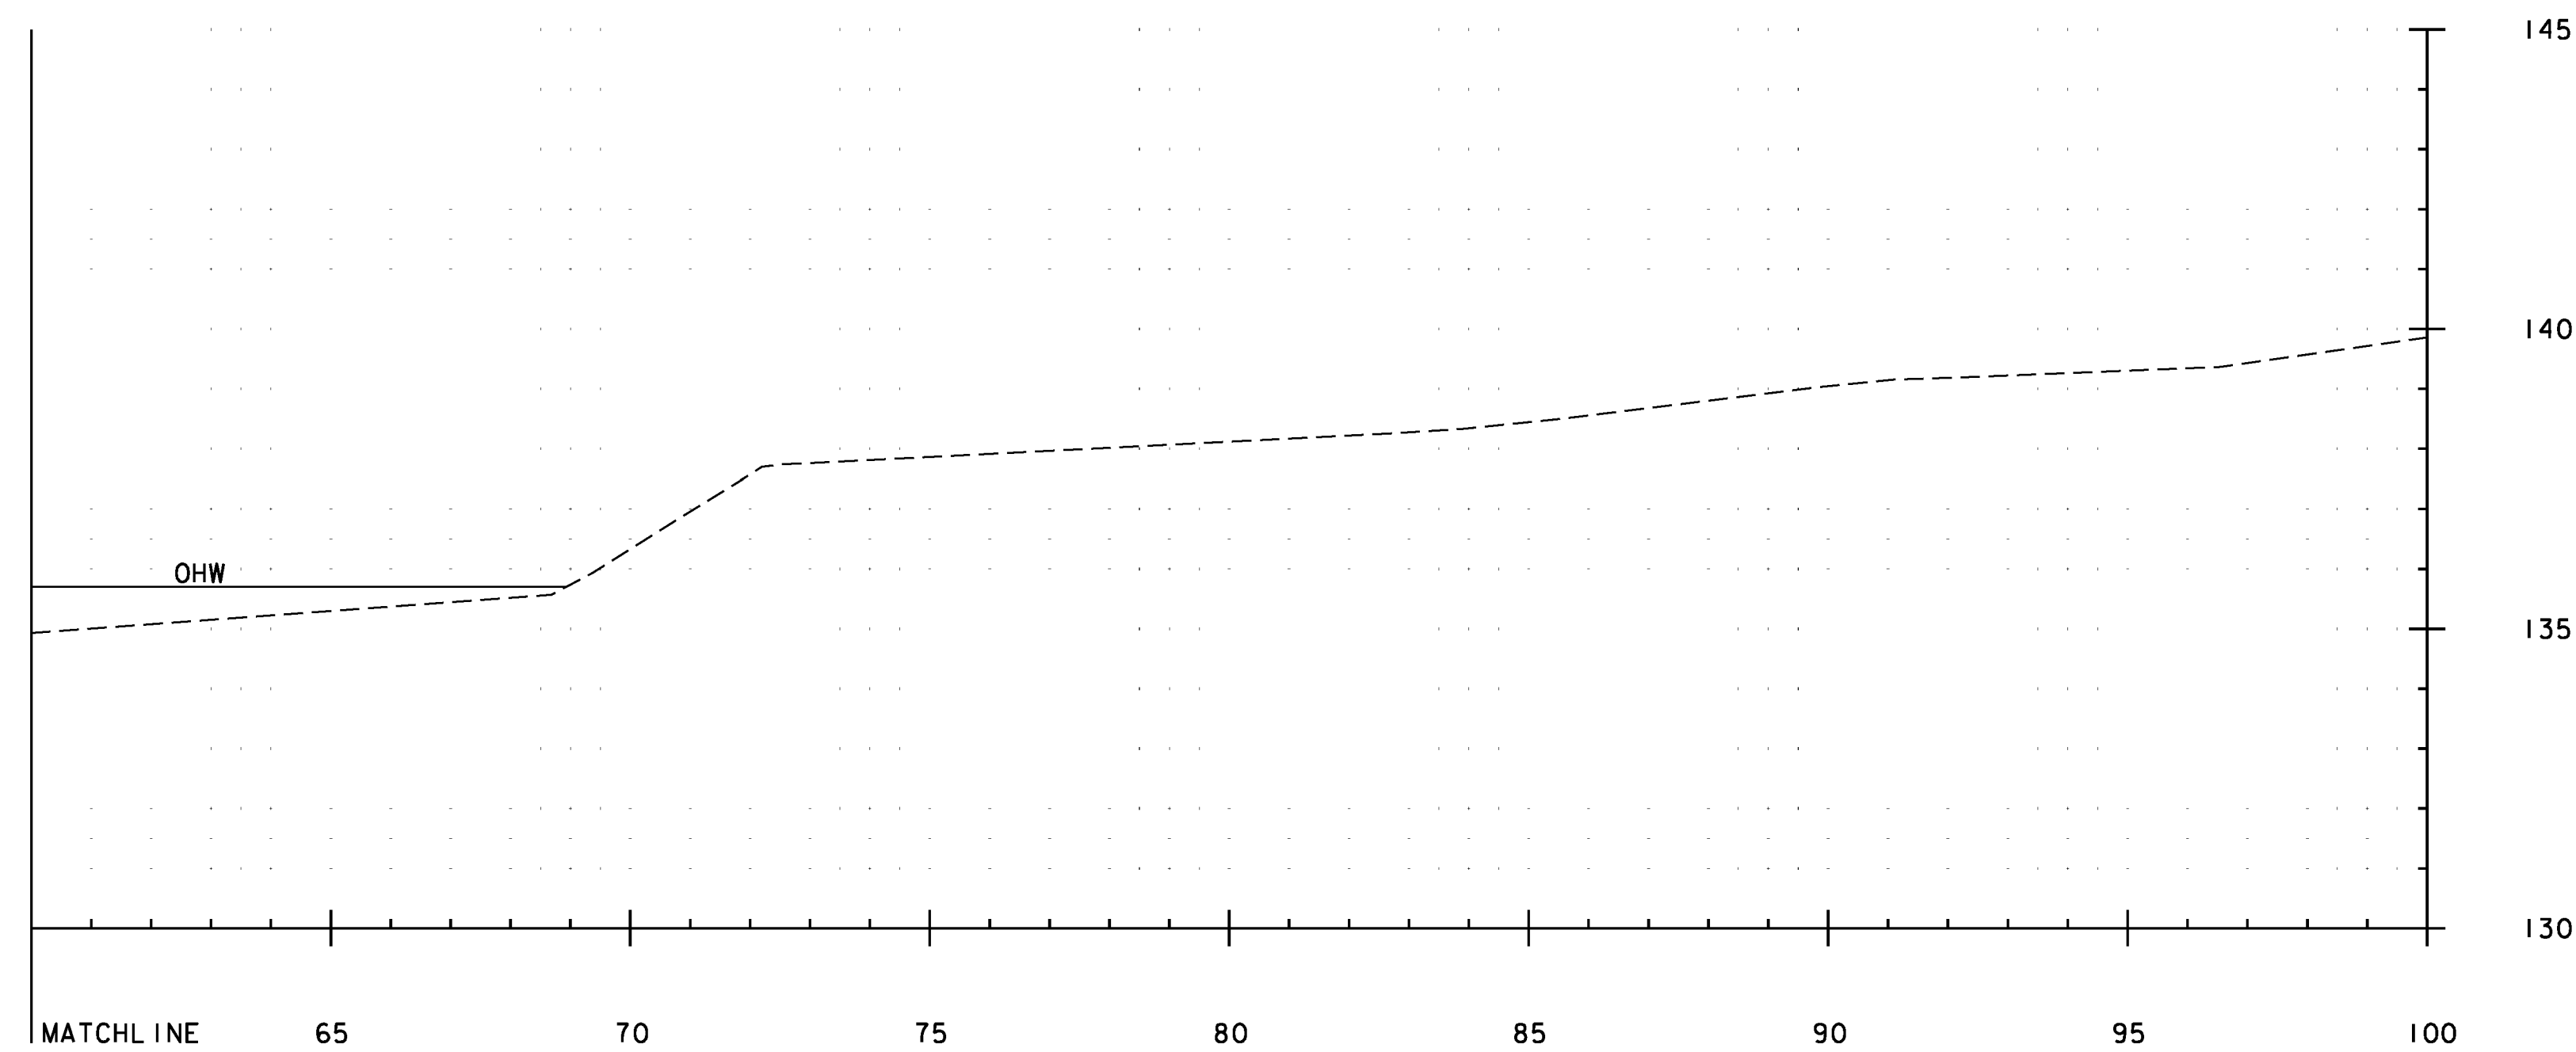


STATION 50+145 RT. RECREATION PATH
 END AGGREGATE SURFACE COURSE
 END SUBBASE OF DENSE GRADED CRUSHED STONE
 END UNCLASSIFIED CHANNEL EXCAVATION

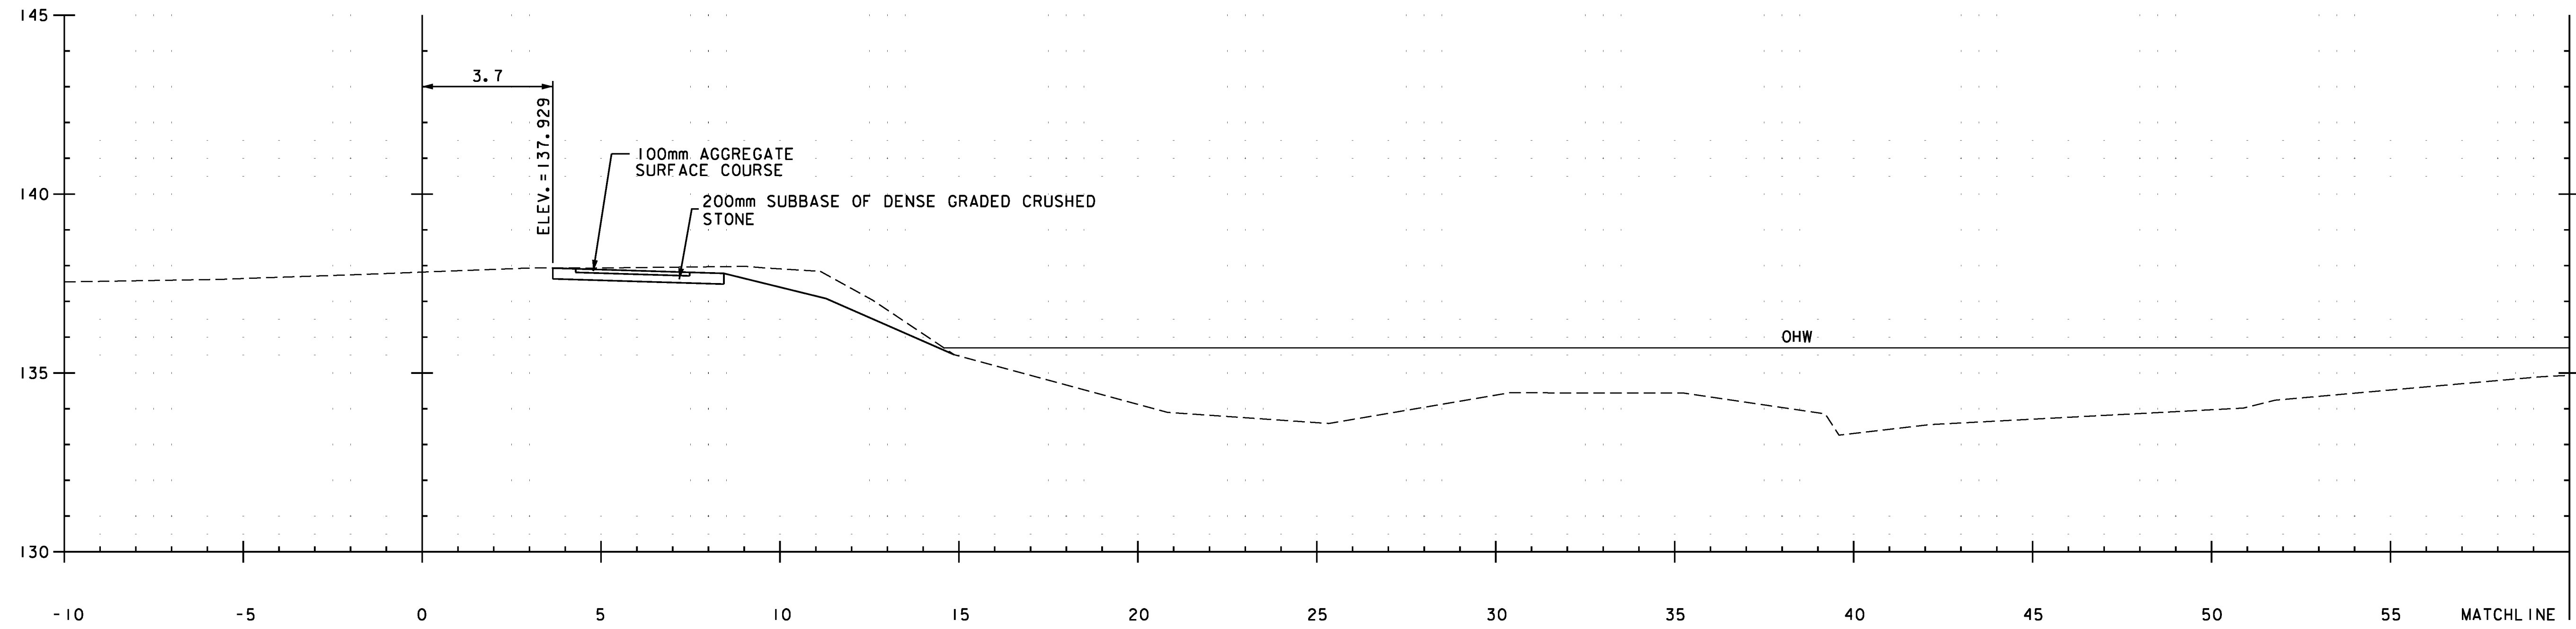

50+125.000

NOTE:
 STATION 50+125 RT. RECREATION PATH
 BEGIN AGGREGATE SURFACE COURSE
 END PORTLAND CEMENT CONCRETE SIDEWALK, 125mm
 END SPECIAL PROVISION (REMOVABLE METAL HAND RAILING)

STA 50+125.000

PROJECT NAME: CAMBRIDGE
 PROJECT NUMBER: BRF 027-I(4)

FILE NAME: s78f163chxs.dgn
 PROJECT LEADER: M. EVANS-MONGEON
 DESIGNED BY: T. FILBACH
 CHANNEL SECTION 14

PLOT DATE: 05-JUN-2012
 DRAWN BY: EVANS-MONGEON
 CHECKED BY: S. SCRIBNER
 SHEET 214 OF 214

