

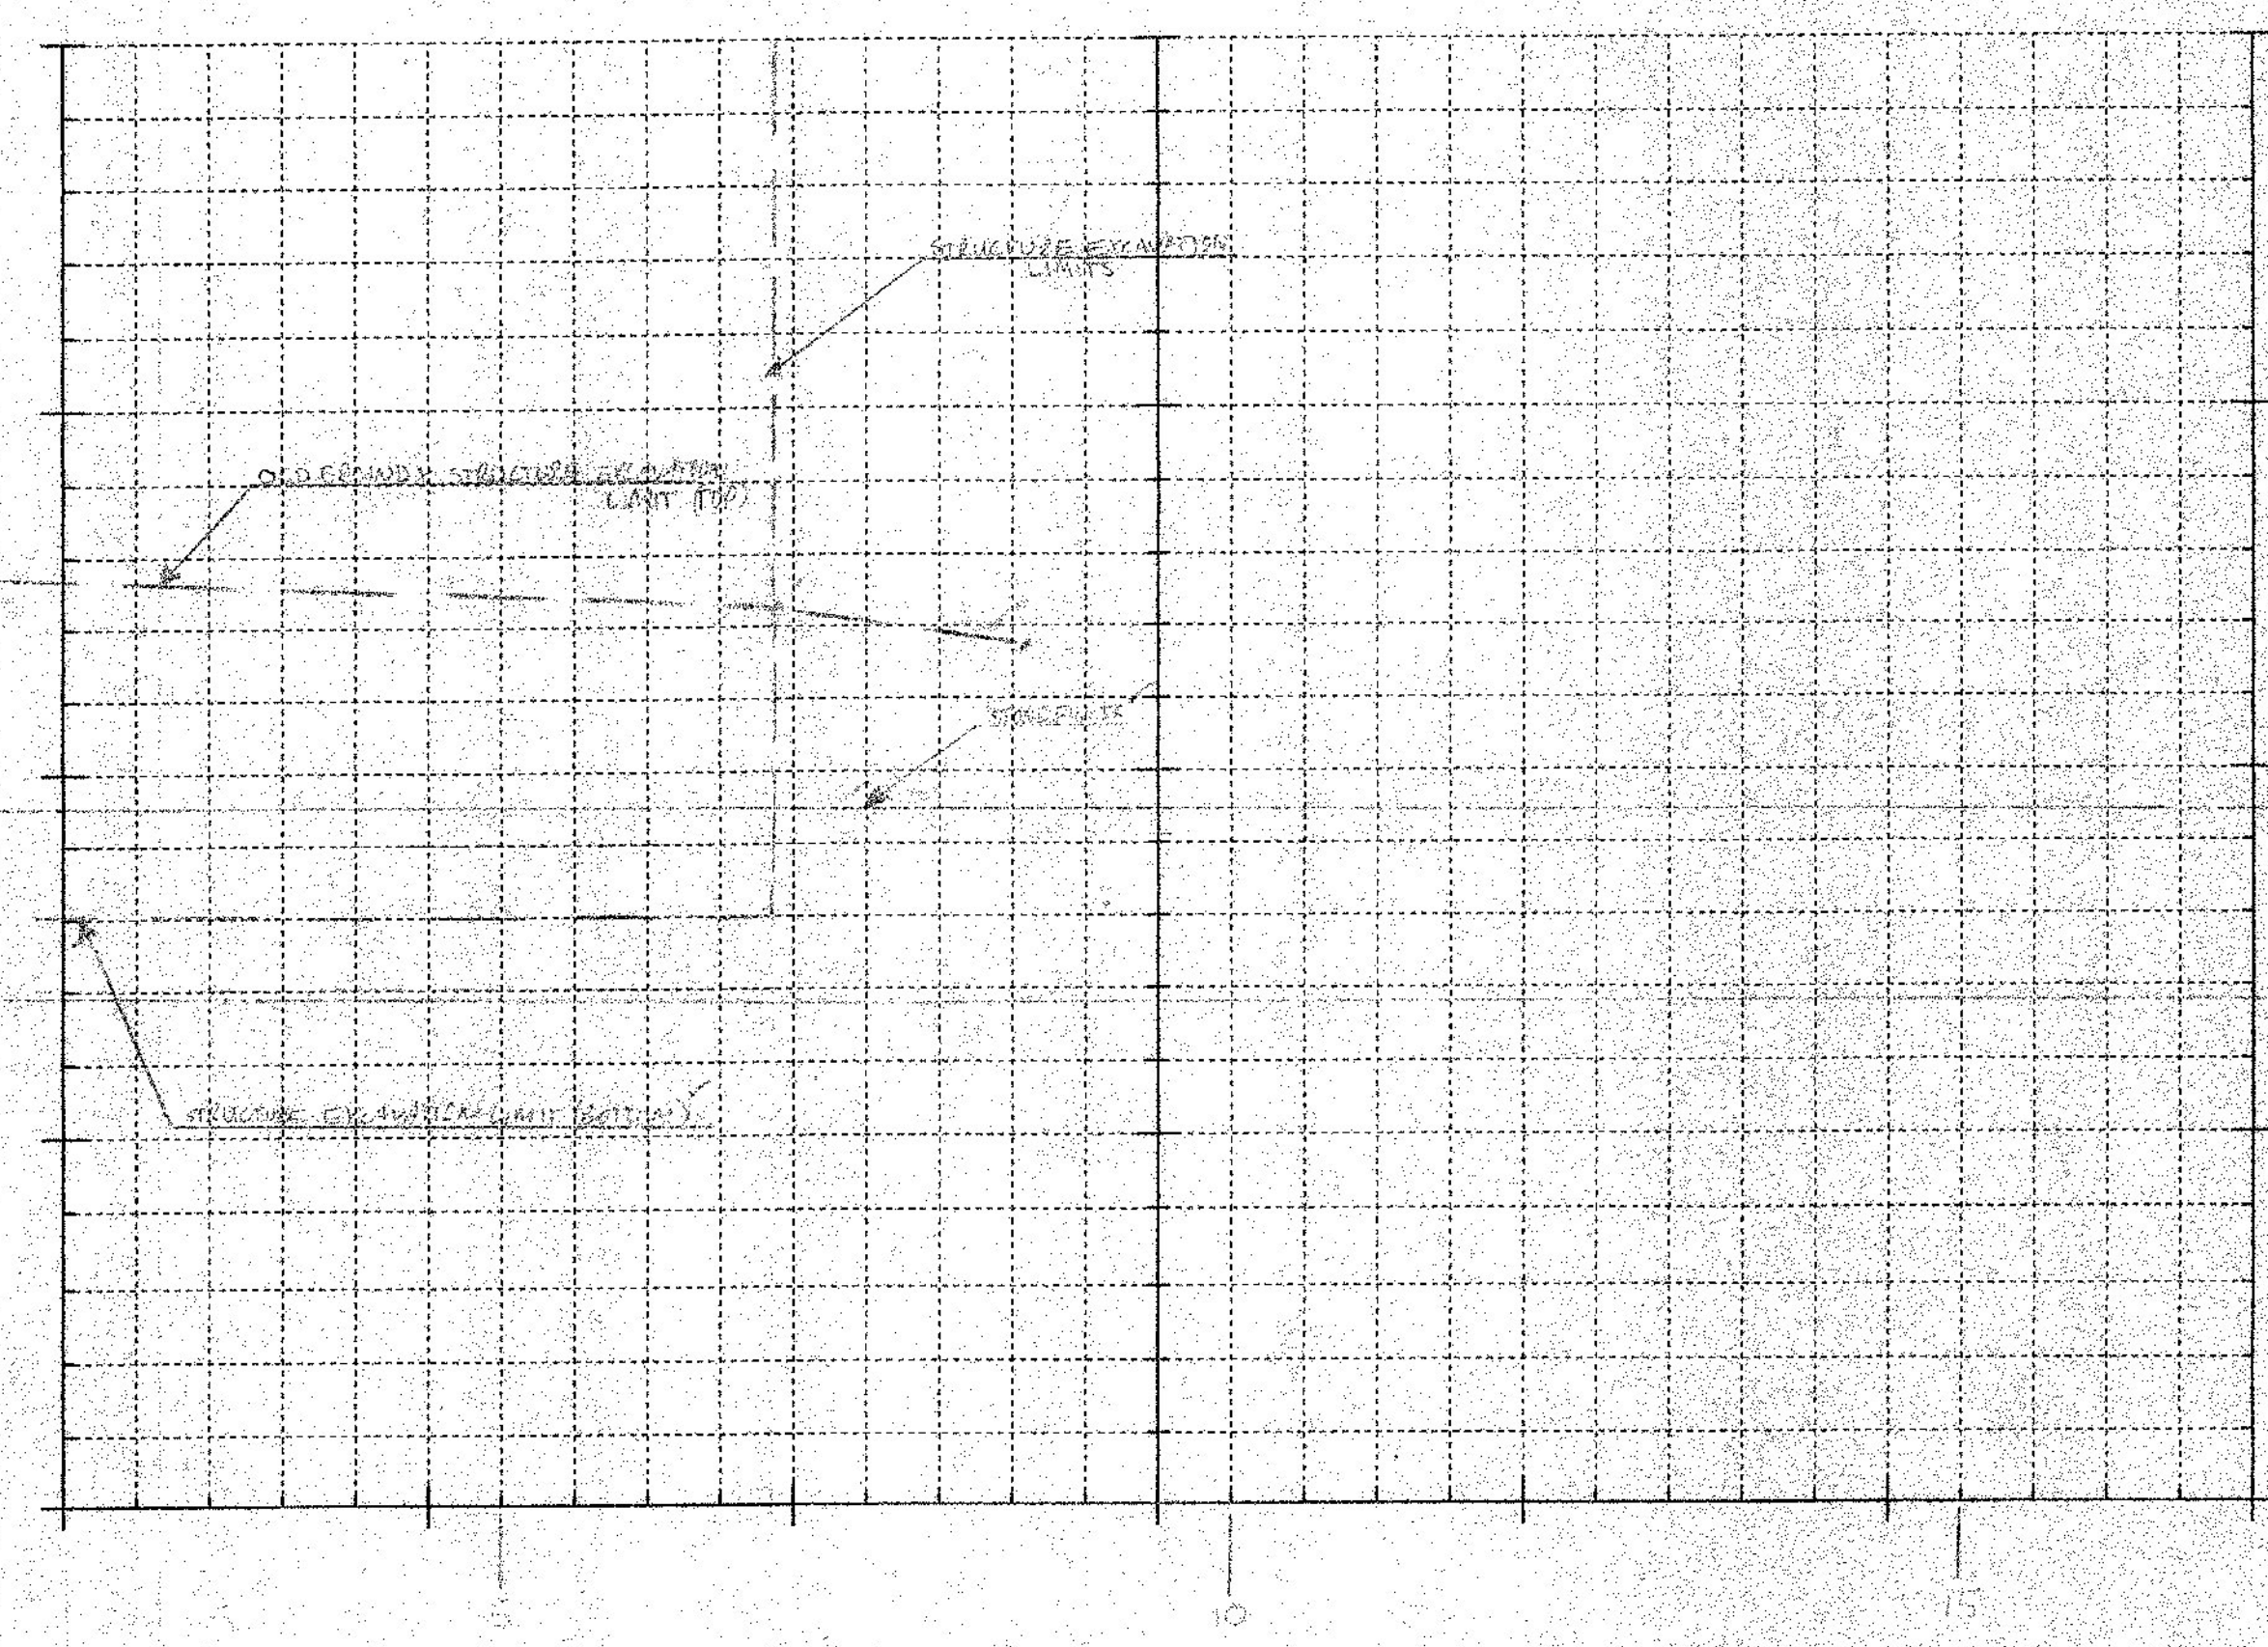


125.24.55  
0.50

\*NOTE: Break point here where  
Alignment #2 starts

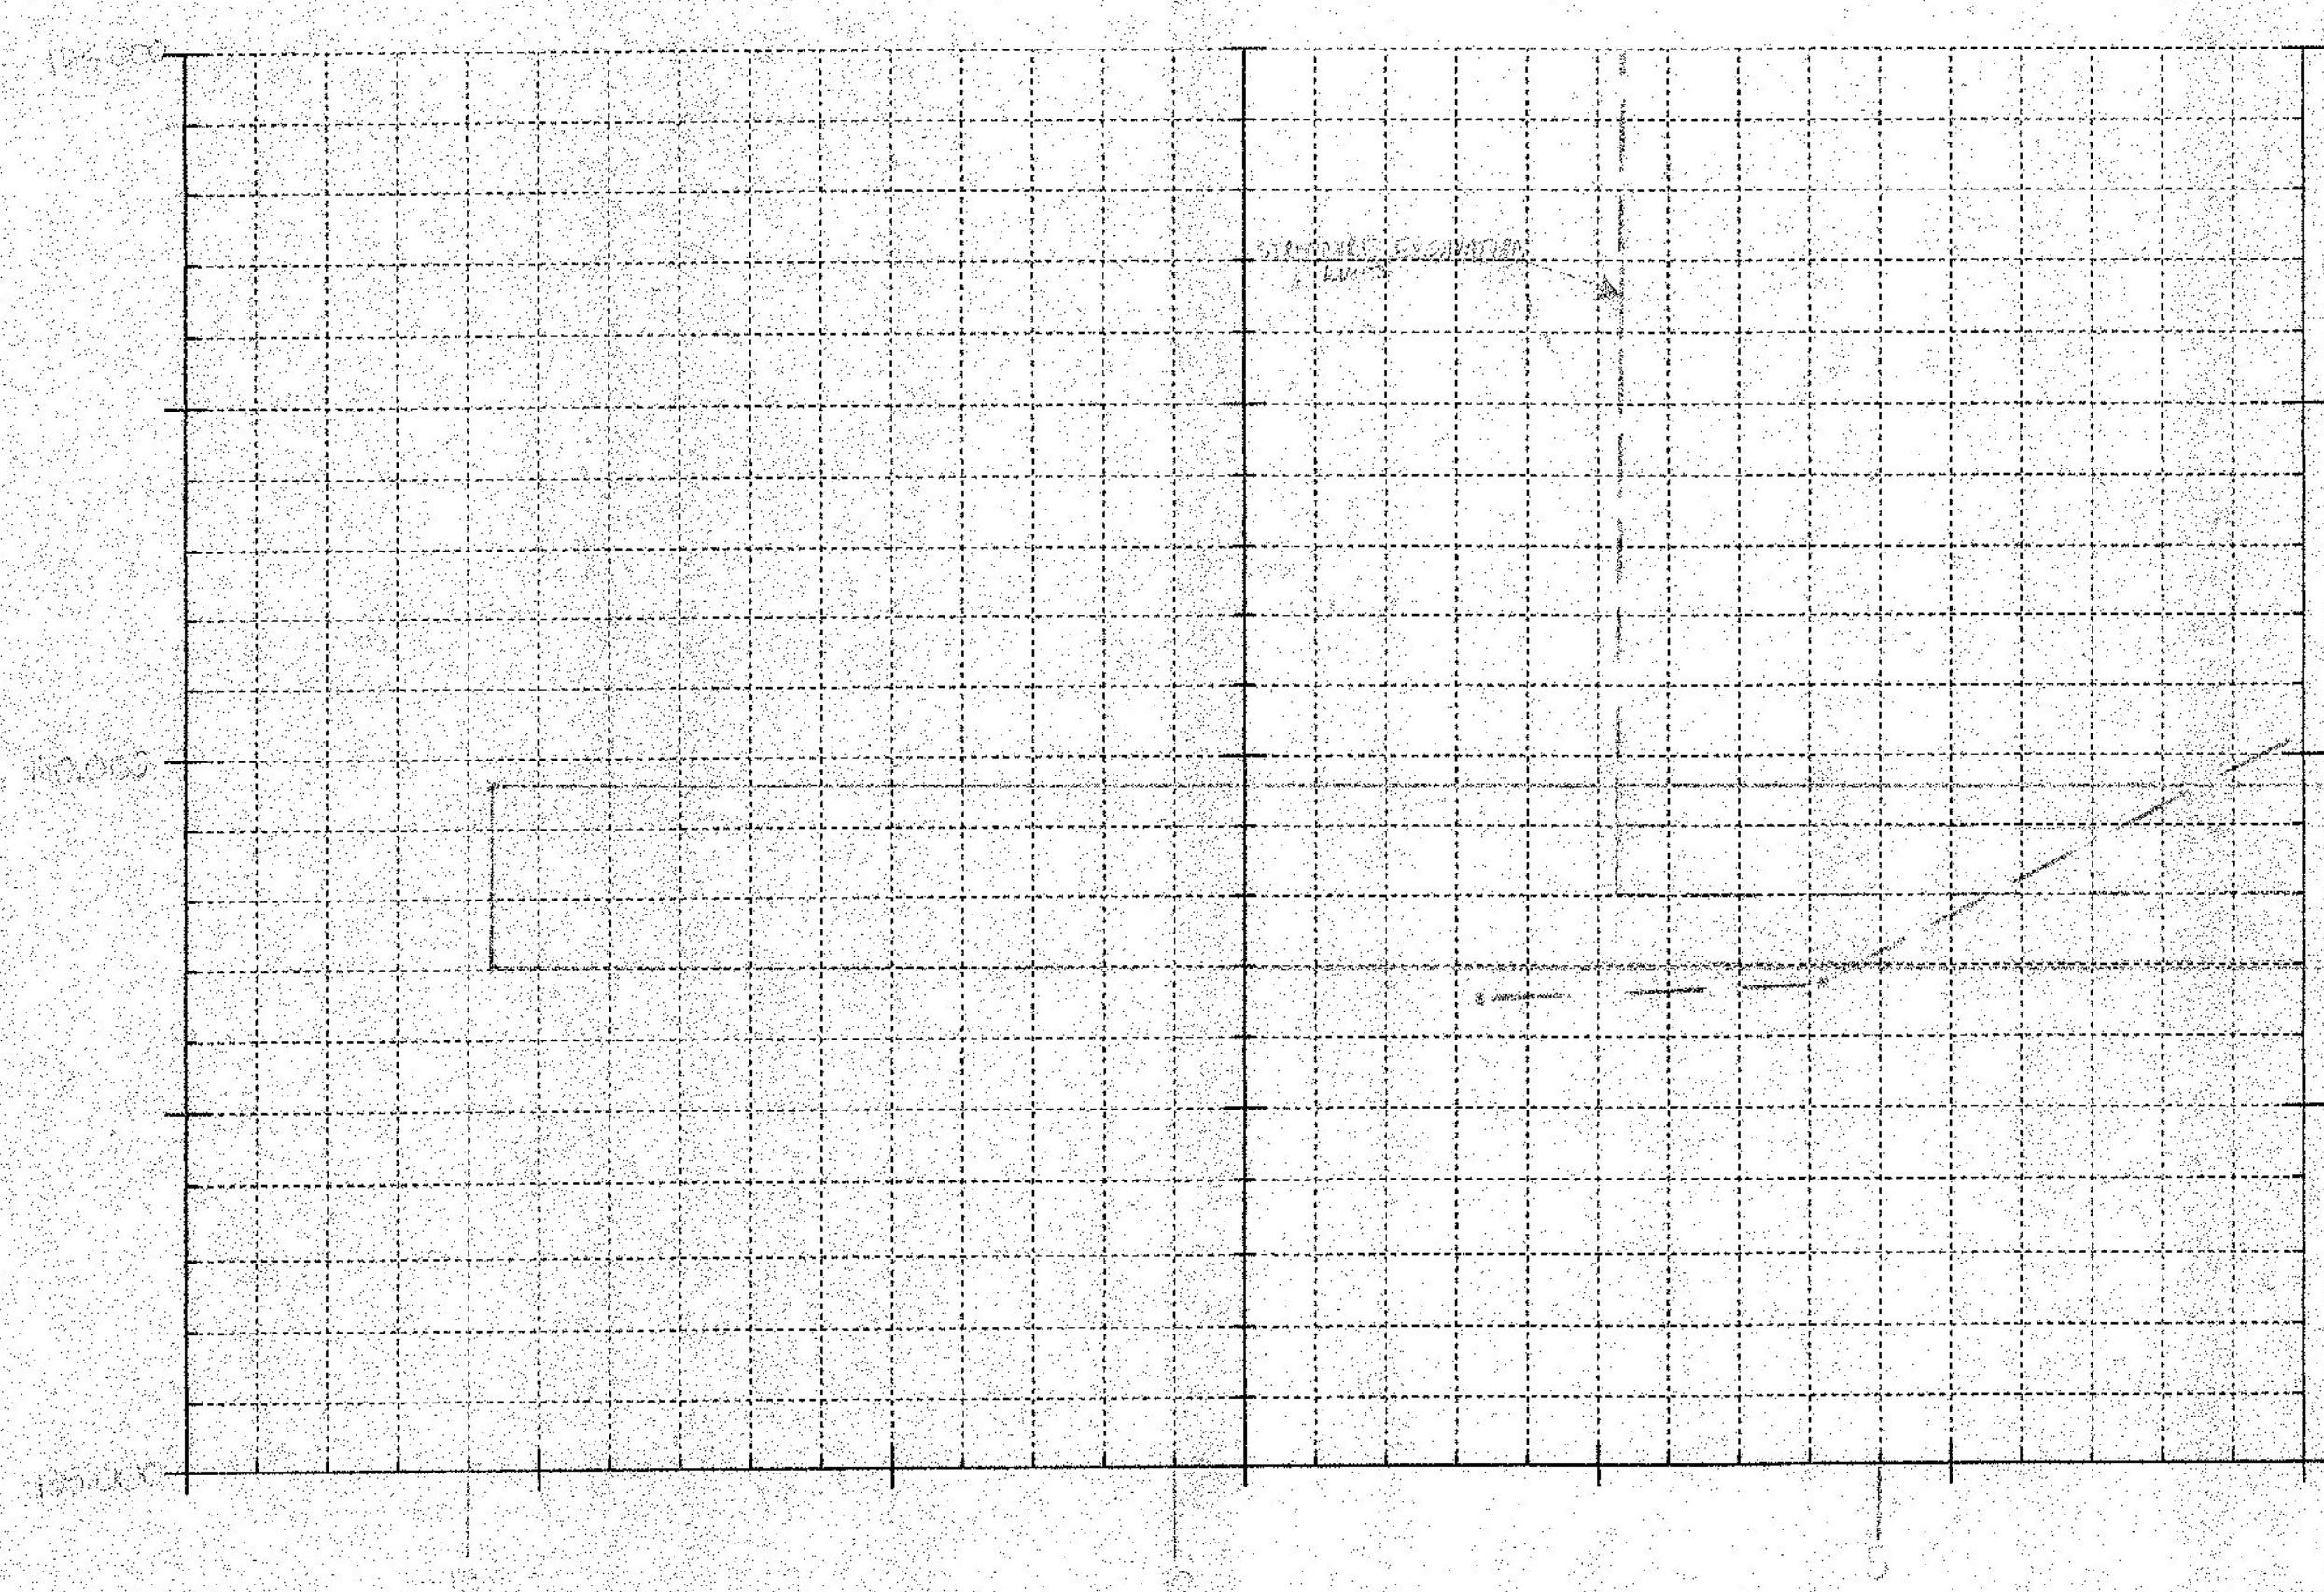

ORIGINAL SECTIONS PLOTTED BY MCI  
PROPOSED TEMPLATE MCI  
10/24/05  
0.50

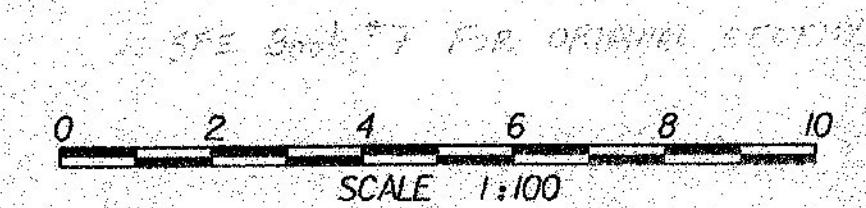

PROJECT:	PROJECT NO.:
DESIGN FILE NAME:	PLOT DATE:
IPARM FILE NAME:	SHEET: OF
MAINLINE ROADWAY SECTIONS	