



10+253.00
-3.95-

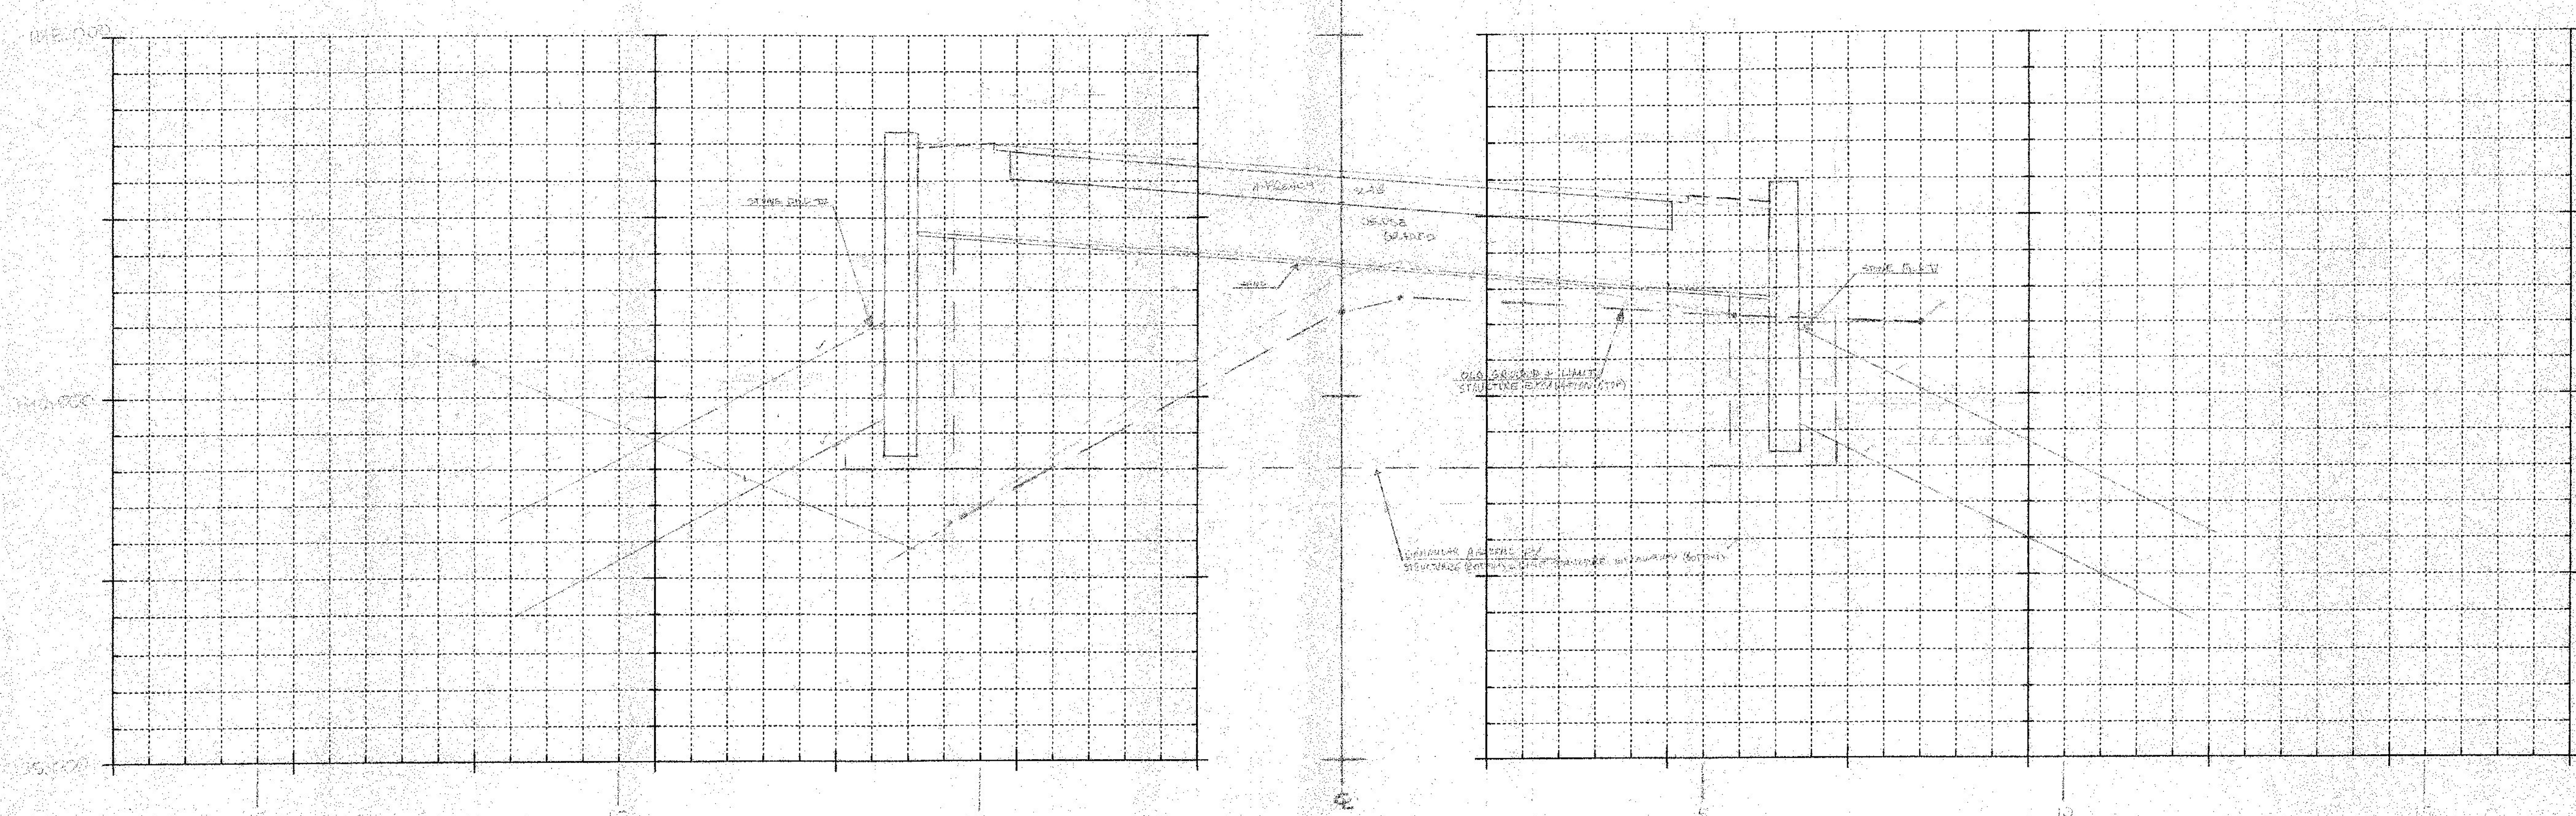

10+250.95
-1.70-

ORIGINAL SECTIONS PLOTTED BY MGE ✓ TPO 03-27-13
PROPOSED TEMPLATES " " " " ✓ TPO 09-27-13

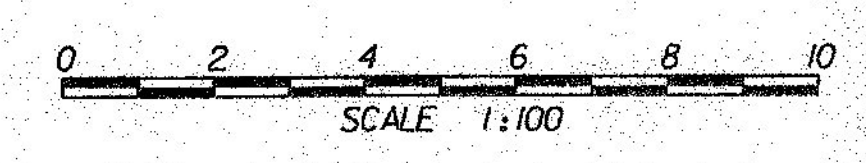

PROJECT: C283122E	PROJECT NO.:
DESIGN FILE NAME: IPARM FILE NAME:	PLOT DATE:
MAINLINE ROADWAY SECTIONS	SHEET: OF