



10/25/2004  
10/25/04

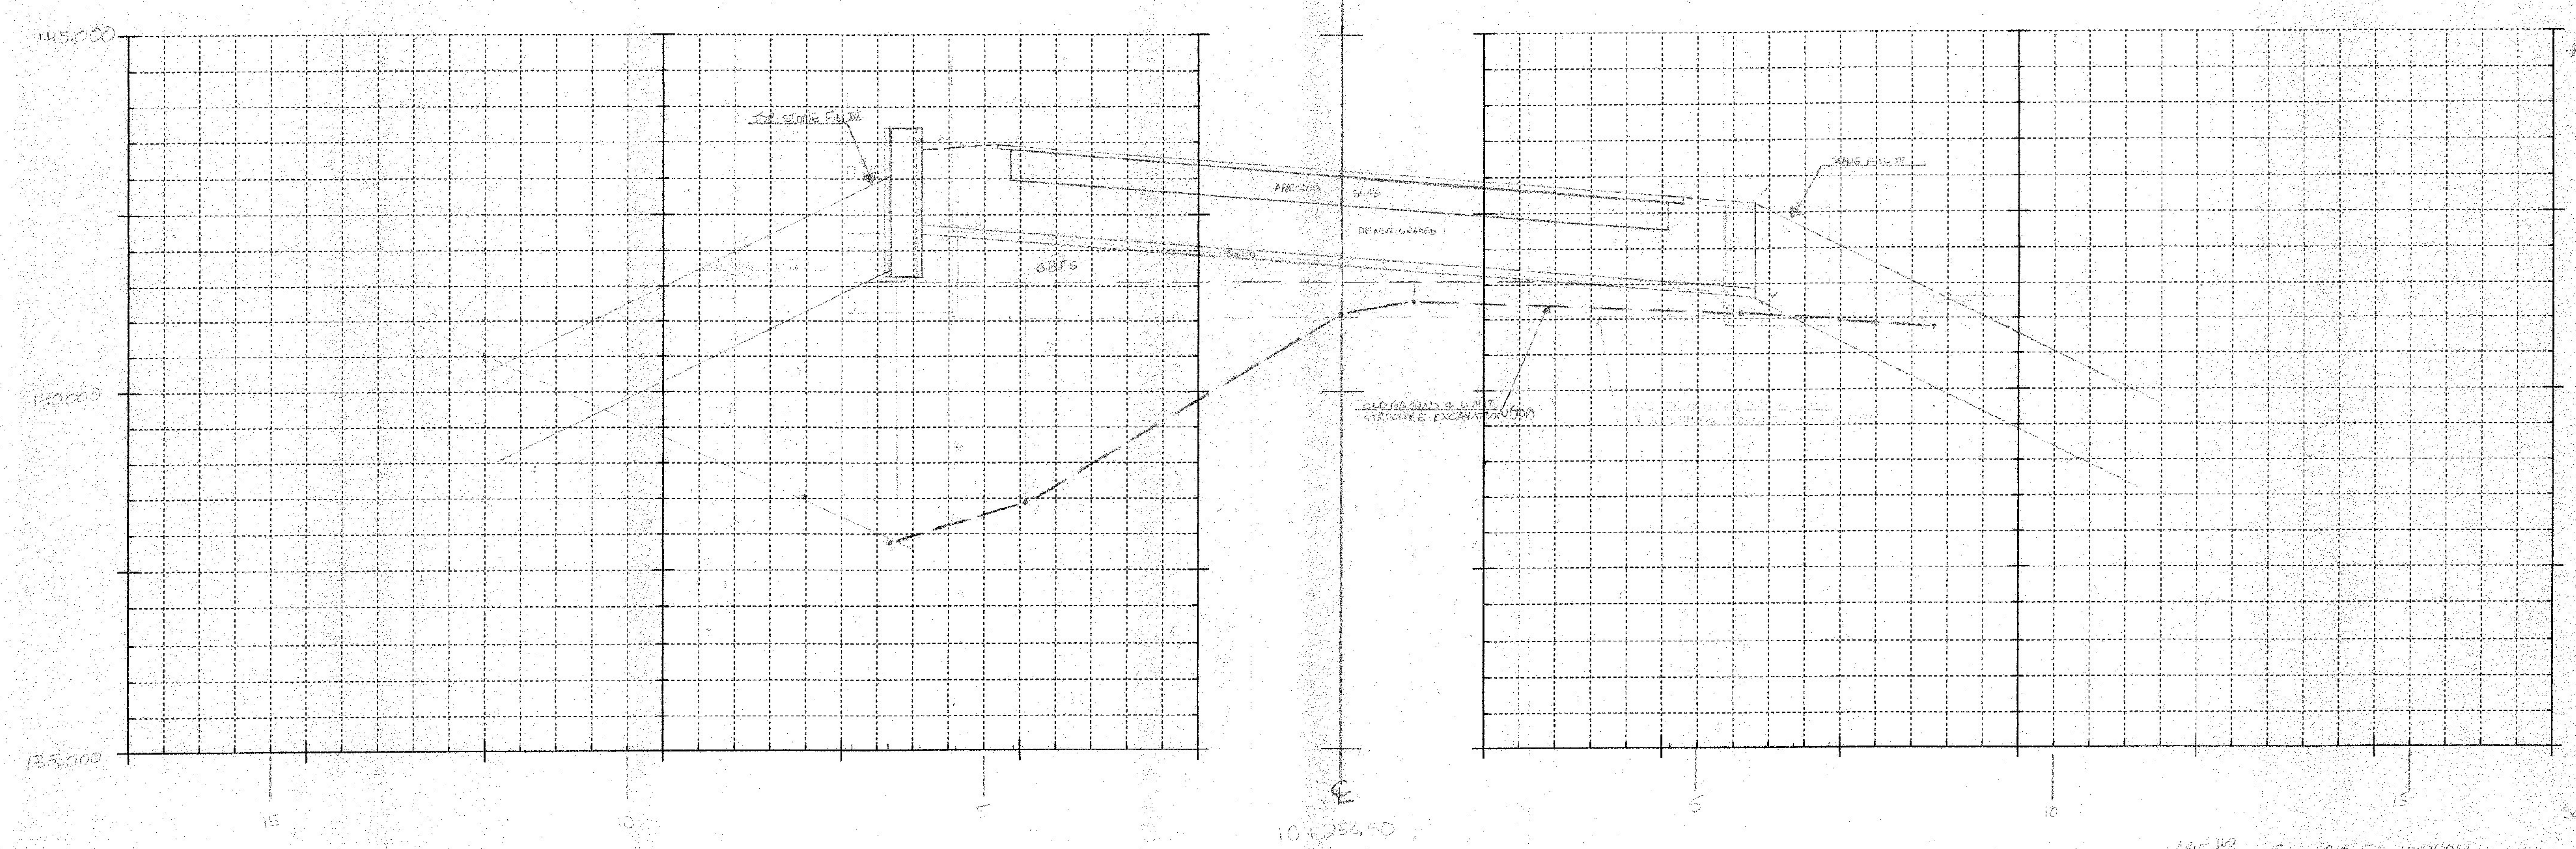

10/25/2004  
10/25/04

ORIGINAL SECTIONS PLOTTED BY MBE 10/25/04  
PROPOSED TEMPLATES BY MBE 10/25/04

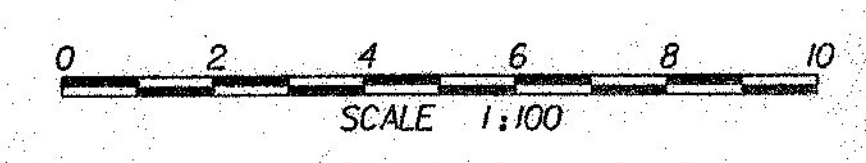

|  |                              |
|--|------------------------------|
| PROJECT: <u>SCALE 1:100</u>              | PROJECT NO.: <u>10/25/04</u> |
| DESIGN FILE NAME: <u>10/25/04</u>        | PLOT DATE: <u>10/25/04</u>   |
| IPARM FILE NAME: <u>MAINLINE SECTION</u> | MAINLINE ROADWAY SECTIONS    |
| SHEET: <u>1</u> OF <u>1</u>              |                              |

SCALE 1:100