


ORIGINAL SECTIONS PLOTTED BY H&M  
 PLOTTED TEMPLATES

DO NOT USE

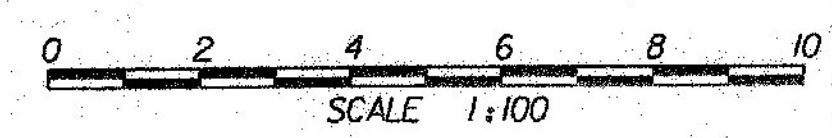

PROJECT: <i>ALBANY STREET EXHAUSTION</i>	PROJECT NO.: <i>881</i>
DESIGN FILE NAME: <i>11/14/13</i>	PLOT DATE: <i>01-28-13</i>
MAINLINE ROADWAY SECTIONS	
SHEET: <i>5</i> OF <i>5</i>	