


MCE 11/13 Original Sections Plotted JPB 07-21-13
 MBE 11/13 Original Sections Plotted JPB 07-21-13
 Original Sections Plotted JPB 07-21-13
 Original Sections Plotted JPB 07-21-13

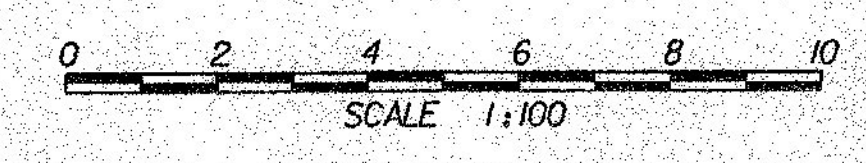

PROJECT:	PROJECT NO.:
DESIGN FILE NAME:	PLOT DATE:
IPARM FILE NAME:	
MAINLINE ROADWAY SECTIONS	SHEET: OF