



10+170.28

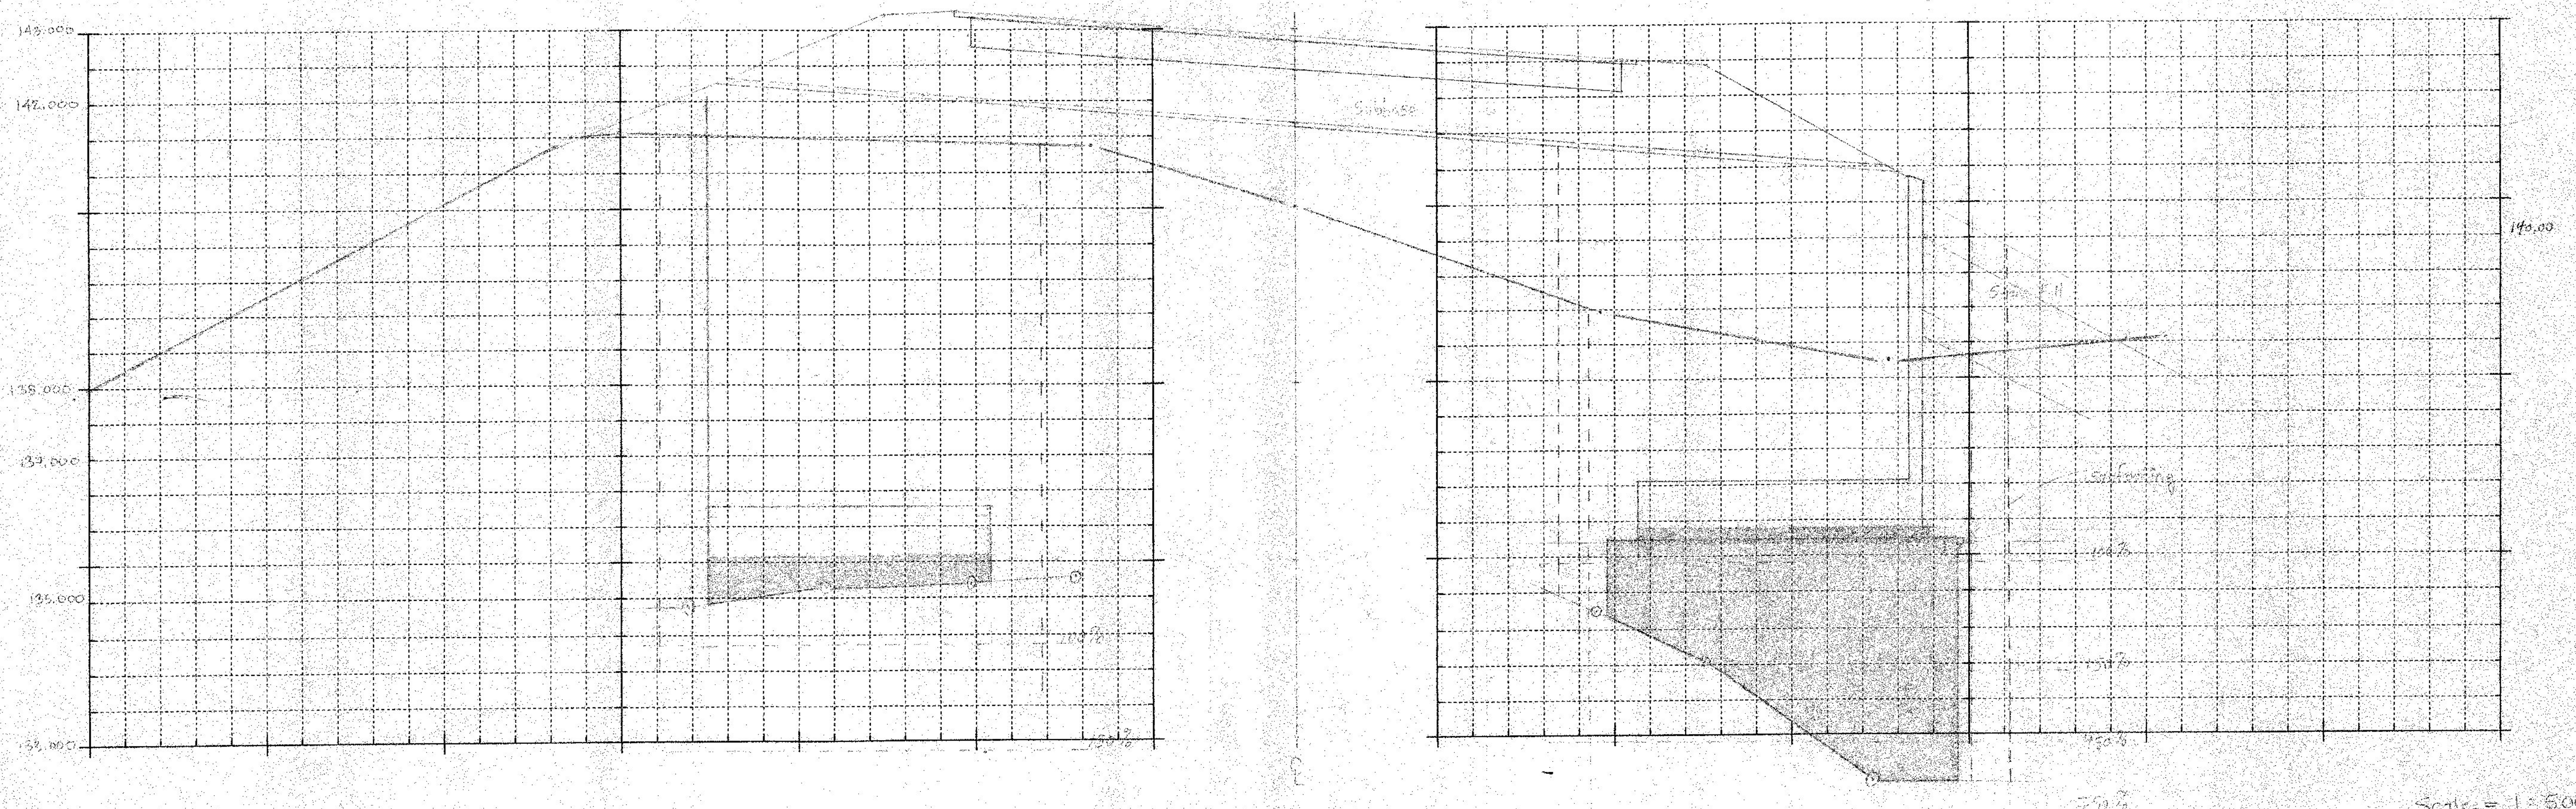

Scale = 1" = 500'

ORIGINAL SECTIONS PLOTTED BY SPW 10130119 ✓ HGT 71113 10+169.60  
 PROPOSED TEMPLATES PLOTTED BY JPN 711113 ✓ HGT 71113  
 FINAL SECTIONS " " ✓ HGT 71113

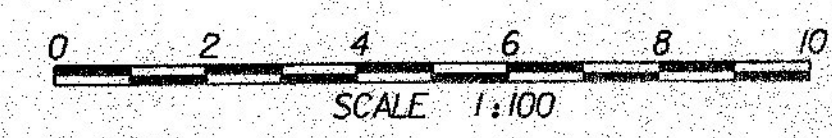

PROJECT: Cambridge	PROJECT NO.: SEE 027.11A
DESIGN FILE NAME: 10111	PLOT DATE: 10-30-12
IPARM FILE NAME: Structure Sections	
MAINLINE ROADWAY SECTIONS	SHEET: 2 OF 3