


ORIGINAL SECTIONS PLOTTED BY SHV 10/20/12 / M.E. 7/1/13  
 PROPOSED TEMPLATES PLOTTED BY JPD 7/1/13 / M.E. 7/1/13  
 FINAL SECTIONS " " / M.E. 7/1/13

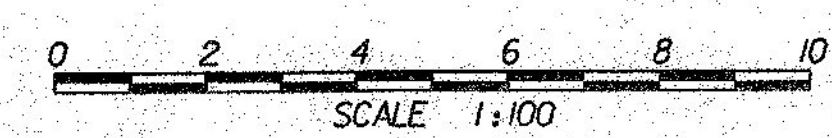

Scale = 1:500

PROJECT: CAMBRIDGE	PROJECT NO.: BRF-027-1(4)
DESIGN FILE NAME: AEW-1	PLOT DATE: 10-30-12
IPARM FILE NAME: STRUCTURE SECTIONS	MAINLINE ROADWAY SECTIONS
SHEET: 3 OF 5	