


ORIGINAL SECTIONS PLOTTED BY STW 10/30/12 ✓ HSE 71113
 PROPOSED TEMPLATES PLOTTED BY JPD 2/11/13 ✓ HSE 71113
 FINAL SECTIONS " " ✓ HSE 71113

Scale 1:500

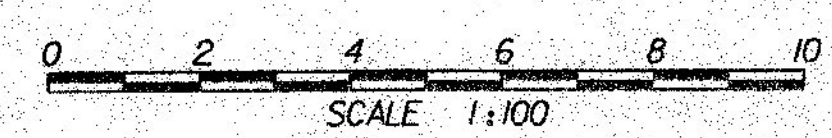

PROJECT: CAMPBELL	PROJECT NO.: RF 027.1(A)
DESIGN FILE NAME: R304	PLOT DATE: 10/24/12
IPARM FILE NAME: STRUCTURE SECTIONS	
MAINLINE ROADWAY SECTIONS	
SHEET: 4 OF 5	