


ORIGINAL SECTIONS PLOTTED BY JPD 7/23/13 / MGR 11-18-13  
 PROPOSED TEMPLATES " " JPD 7/23/13 / MGR 11-18-13  
 FINAL SECTIONS " " " "

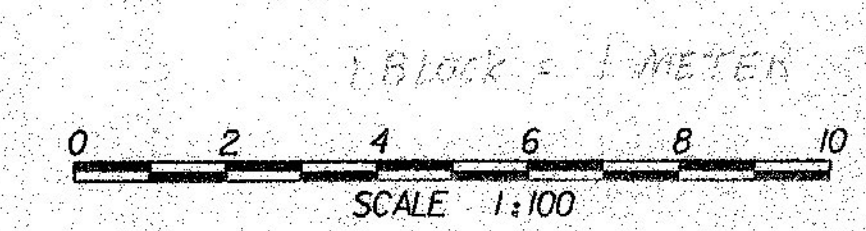

PROJECT:	PROJECT NO.:
DESIGN FILE NAME:	PLOT DATE:
IPARM FILE NAME:	SHEET: OF
MAINLINE ROADWAY SECTIONS	