


145.11-145.11 ② Original Section plotted 03-23-15
 145.11-145.11 ① Proposed Template plotted by
 Metric 12/14

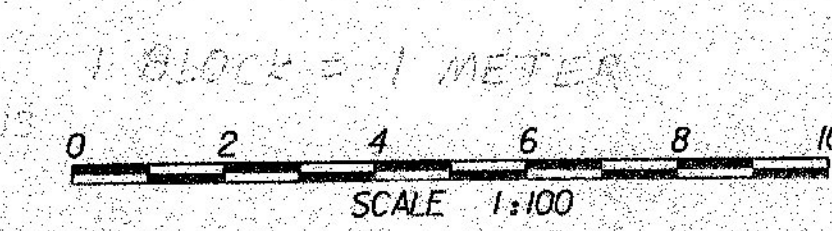

PROJECT: 50+090 BRIDGE	PROJECT NO.: SEE 022-111
DESIGN FILE NAME:	PLOT DATE:
IPARM FILE NAME:	MAINLINE ROADWAY SECTIONS
SHEET: _____	OF _____