


1 Proposed templates plotted by
Final sections plotted by

AGE
11/15/12
11/15/12
11/15/12
© Final section plotted 5/20/12 07-25-12
Mainline sections plotted 5/20/12 07-25-12

1 BLOCK = 1 METER

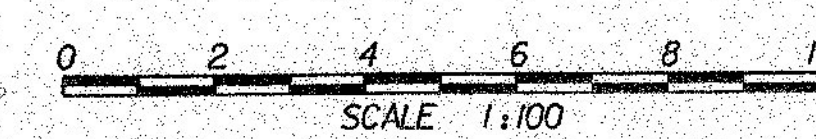

PROJECT: 2288122	PROJECT NO.: 105 622 100
DESIGN FILE NAME:	PLOT DATE:
IPARM FILE NAME:	
MAINLINE ROADWAY SECTIONS	SHEET: OF