


MGI 11-20-13 Original Sections Plotted by JPO 07-18-13
 MGI 11-20-13 Proposed Template
 Final Sections plotted by

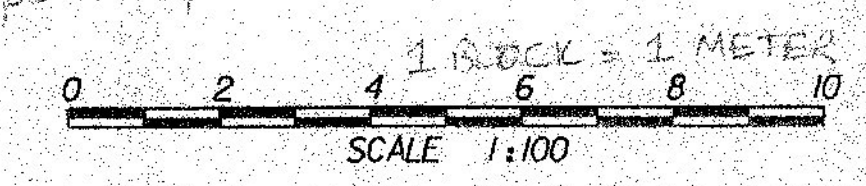

PROJECT: SABRIDGE	PROJECT NO.: 201-027-101
DESIGN FILE NAME: IPARM FILE NAME:	PLOT DATE:
MAINLINE ROADWAY SECTIONS CHANNEL SECTIONS	SHEET: OF