



3 Bearing

10
15
20

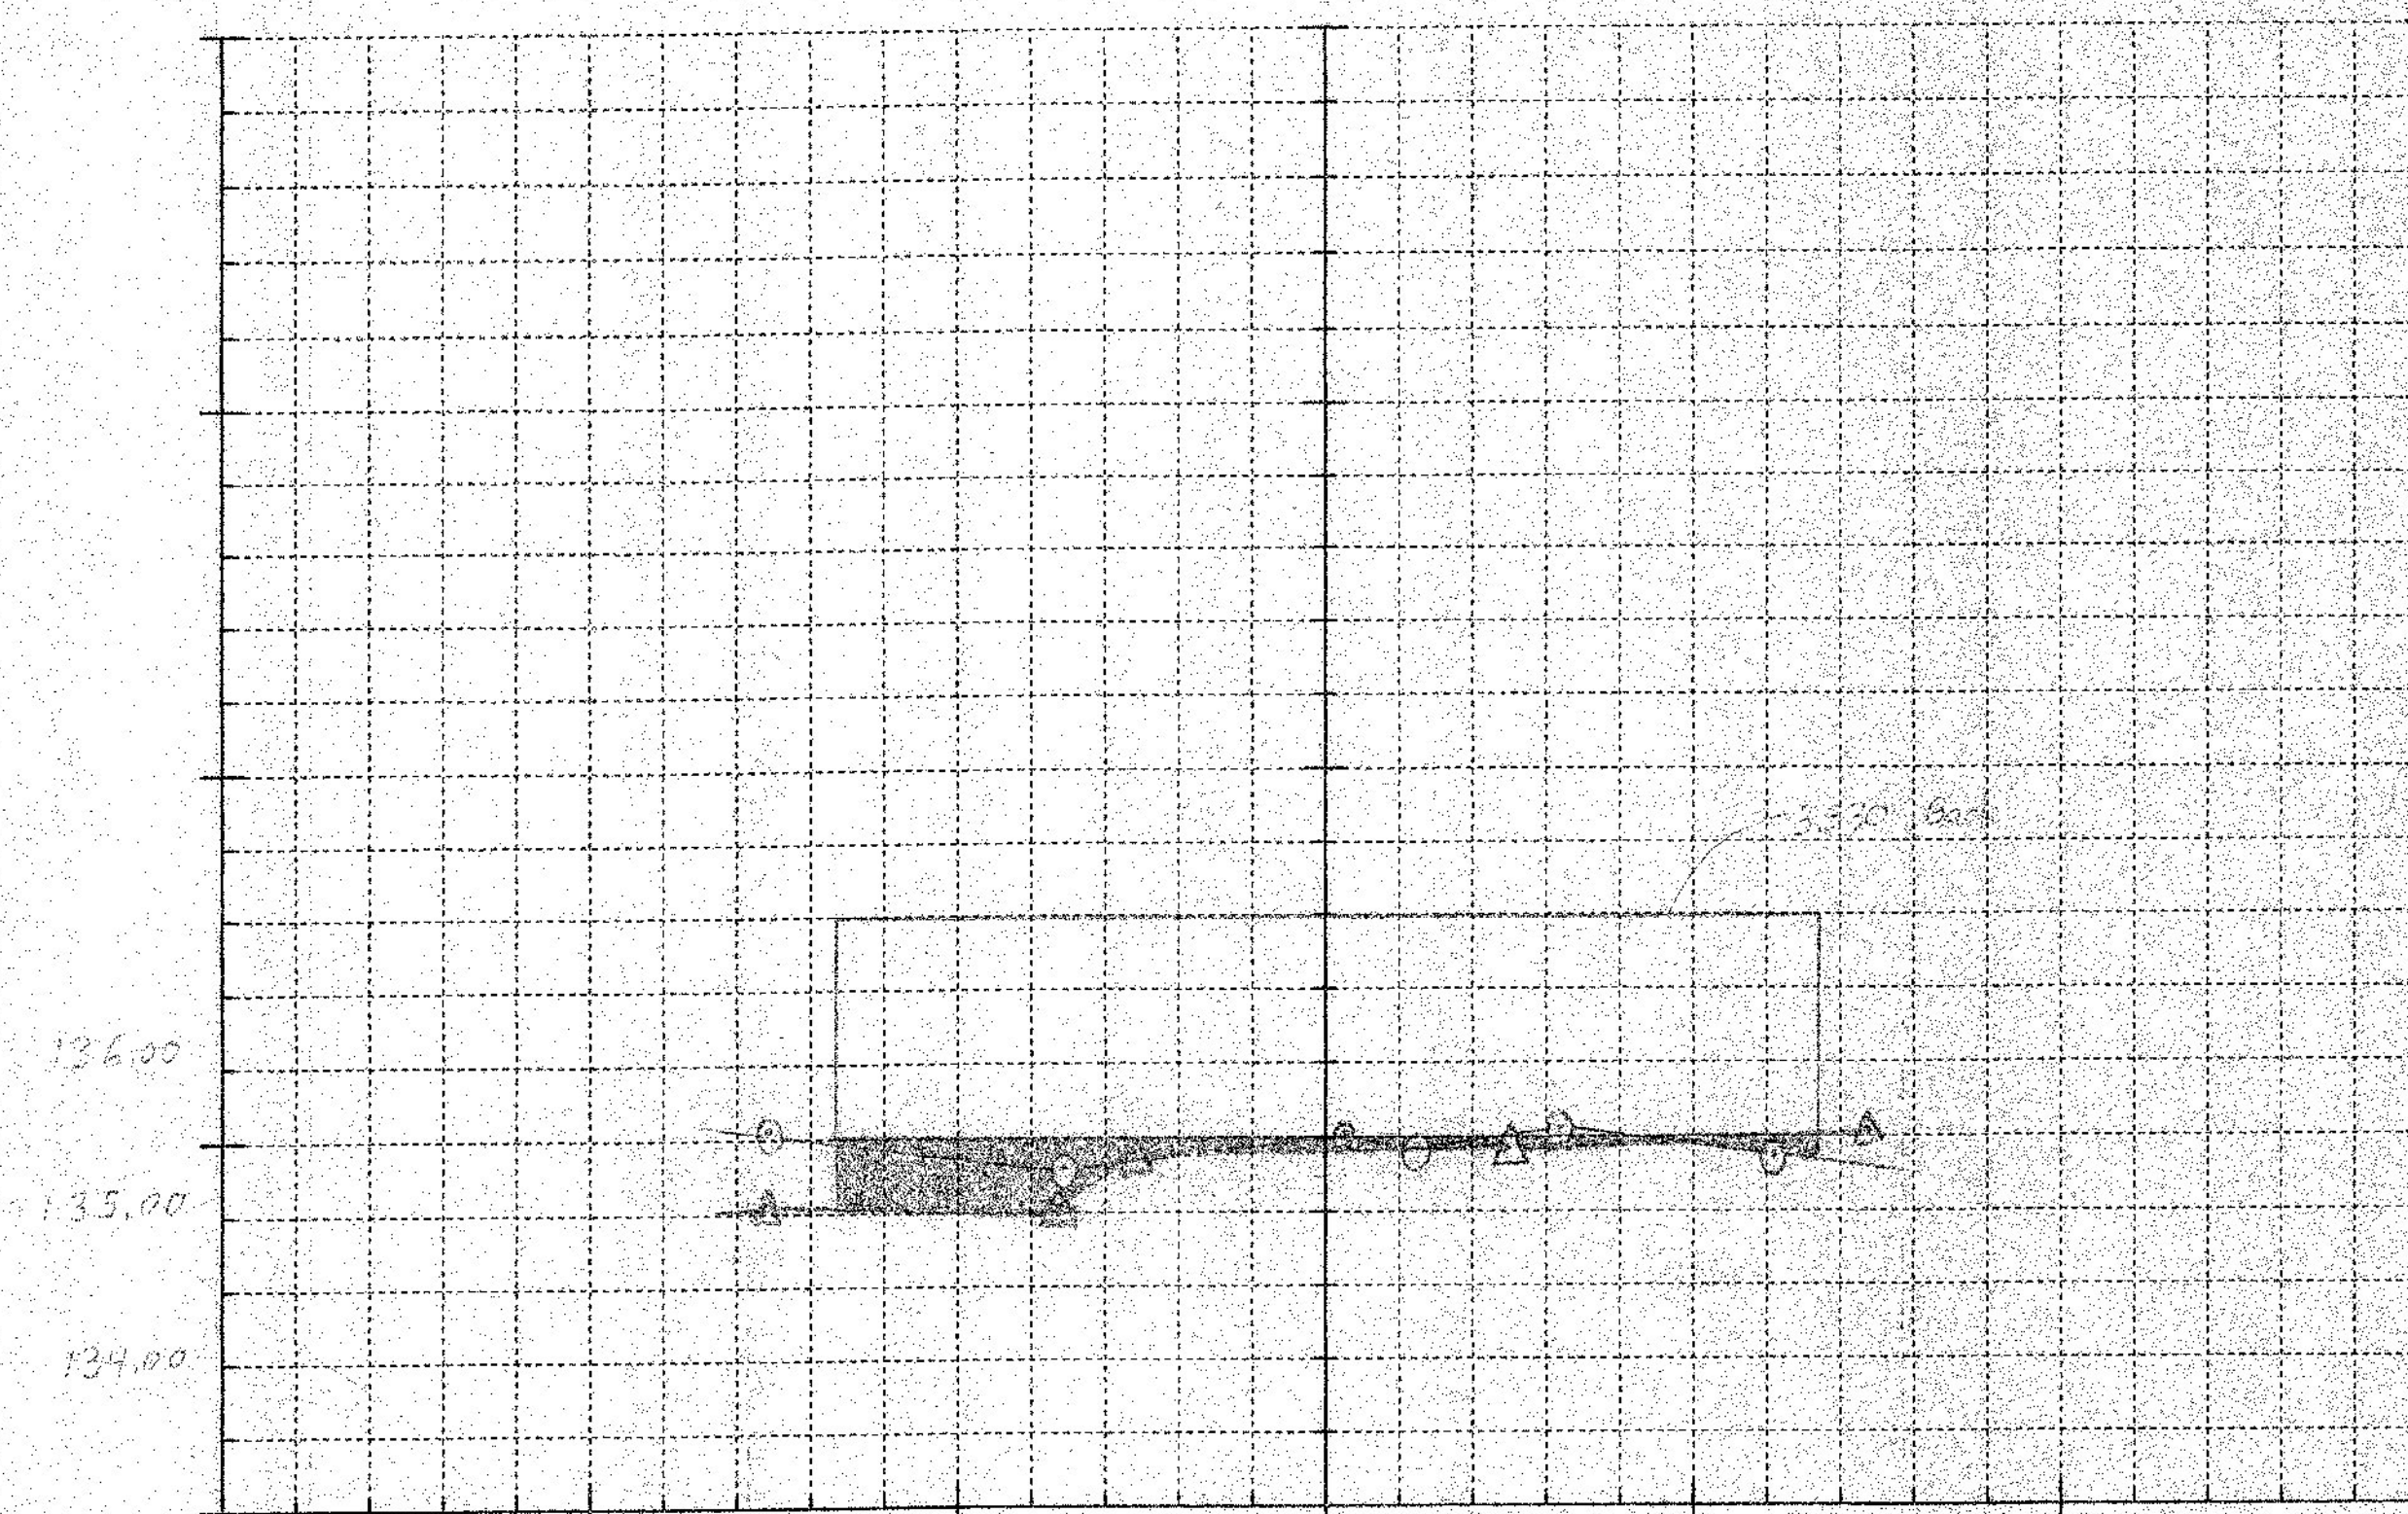


3.320 RT

10
15

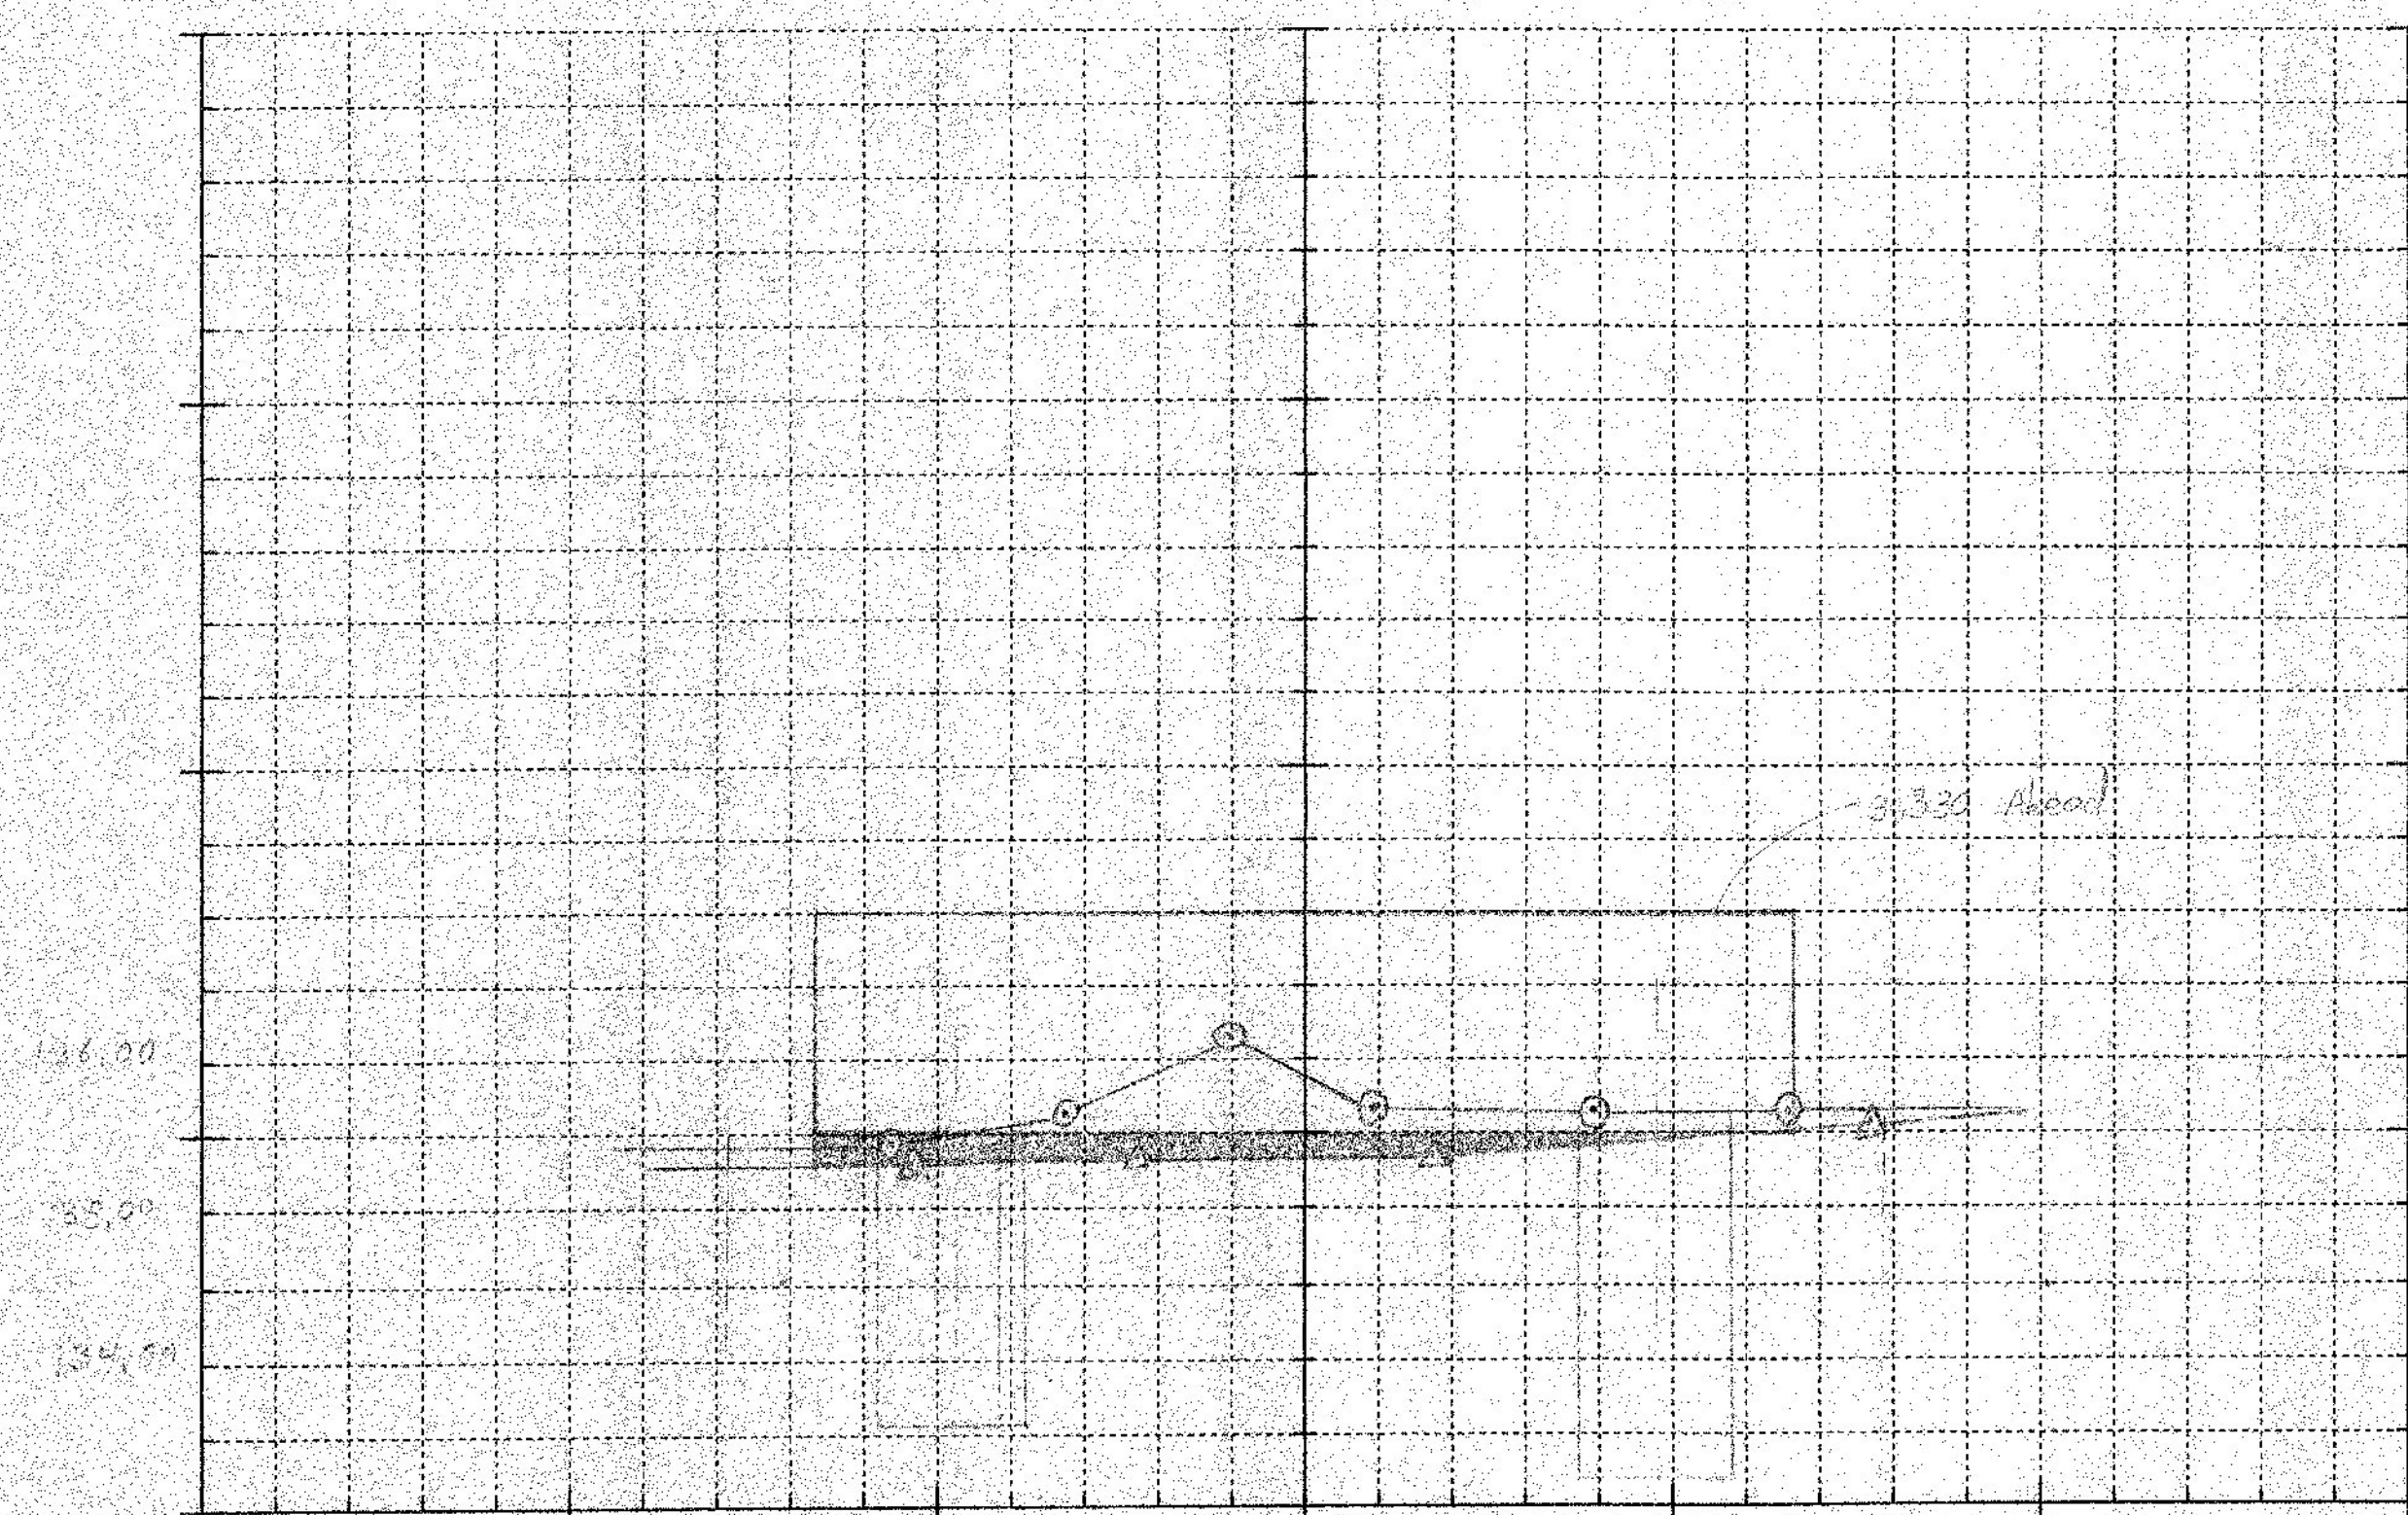

3.320 LT

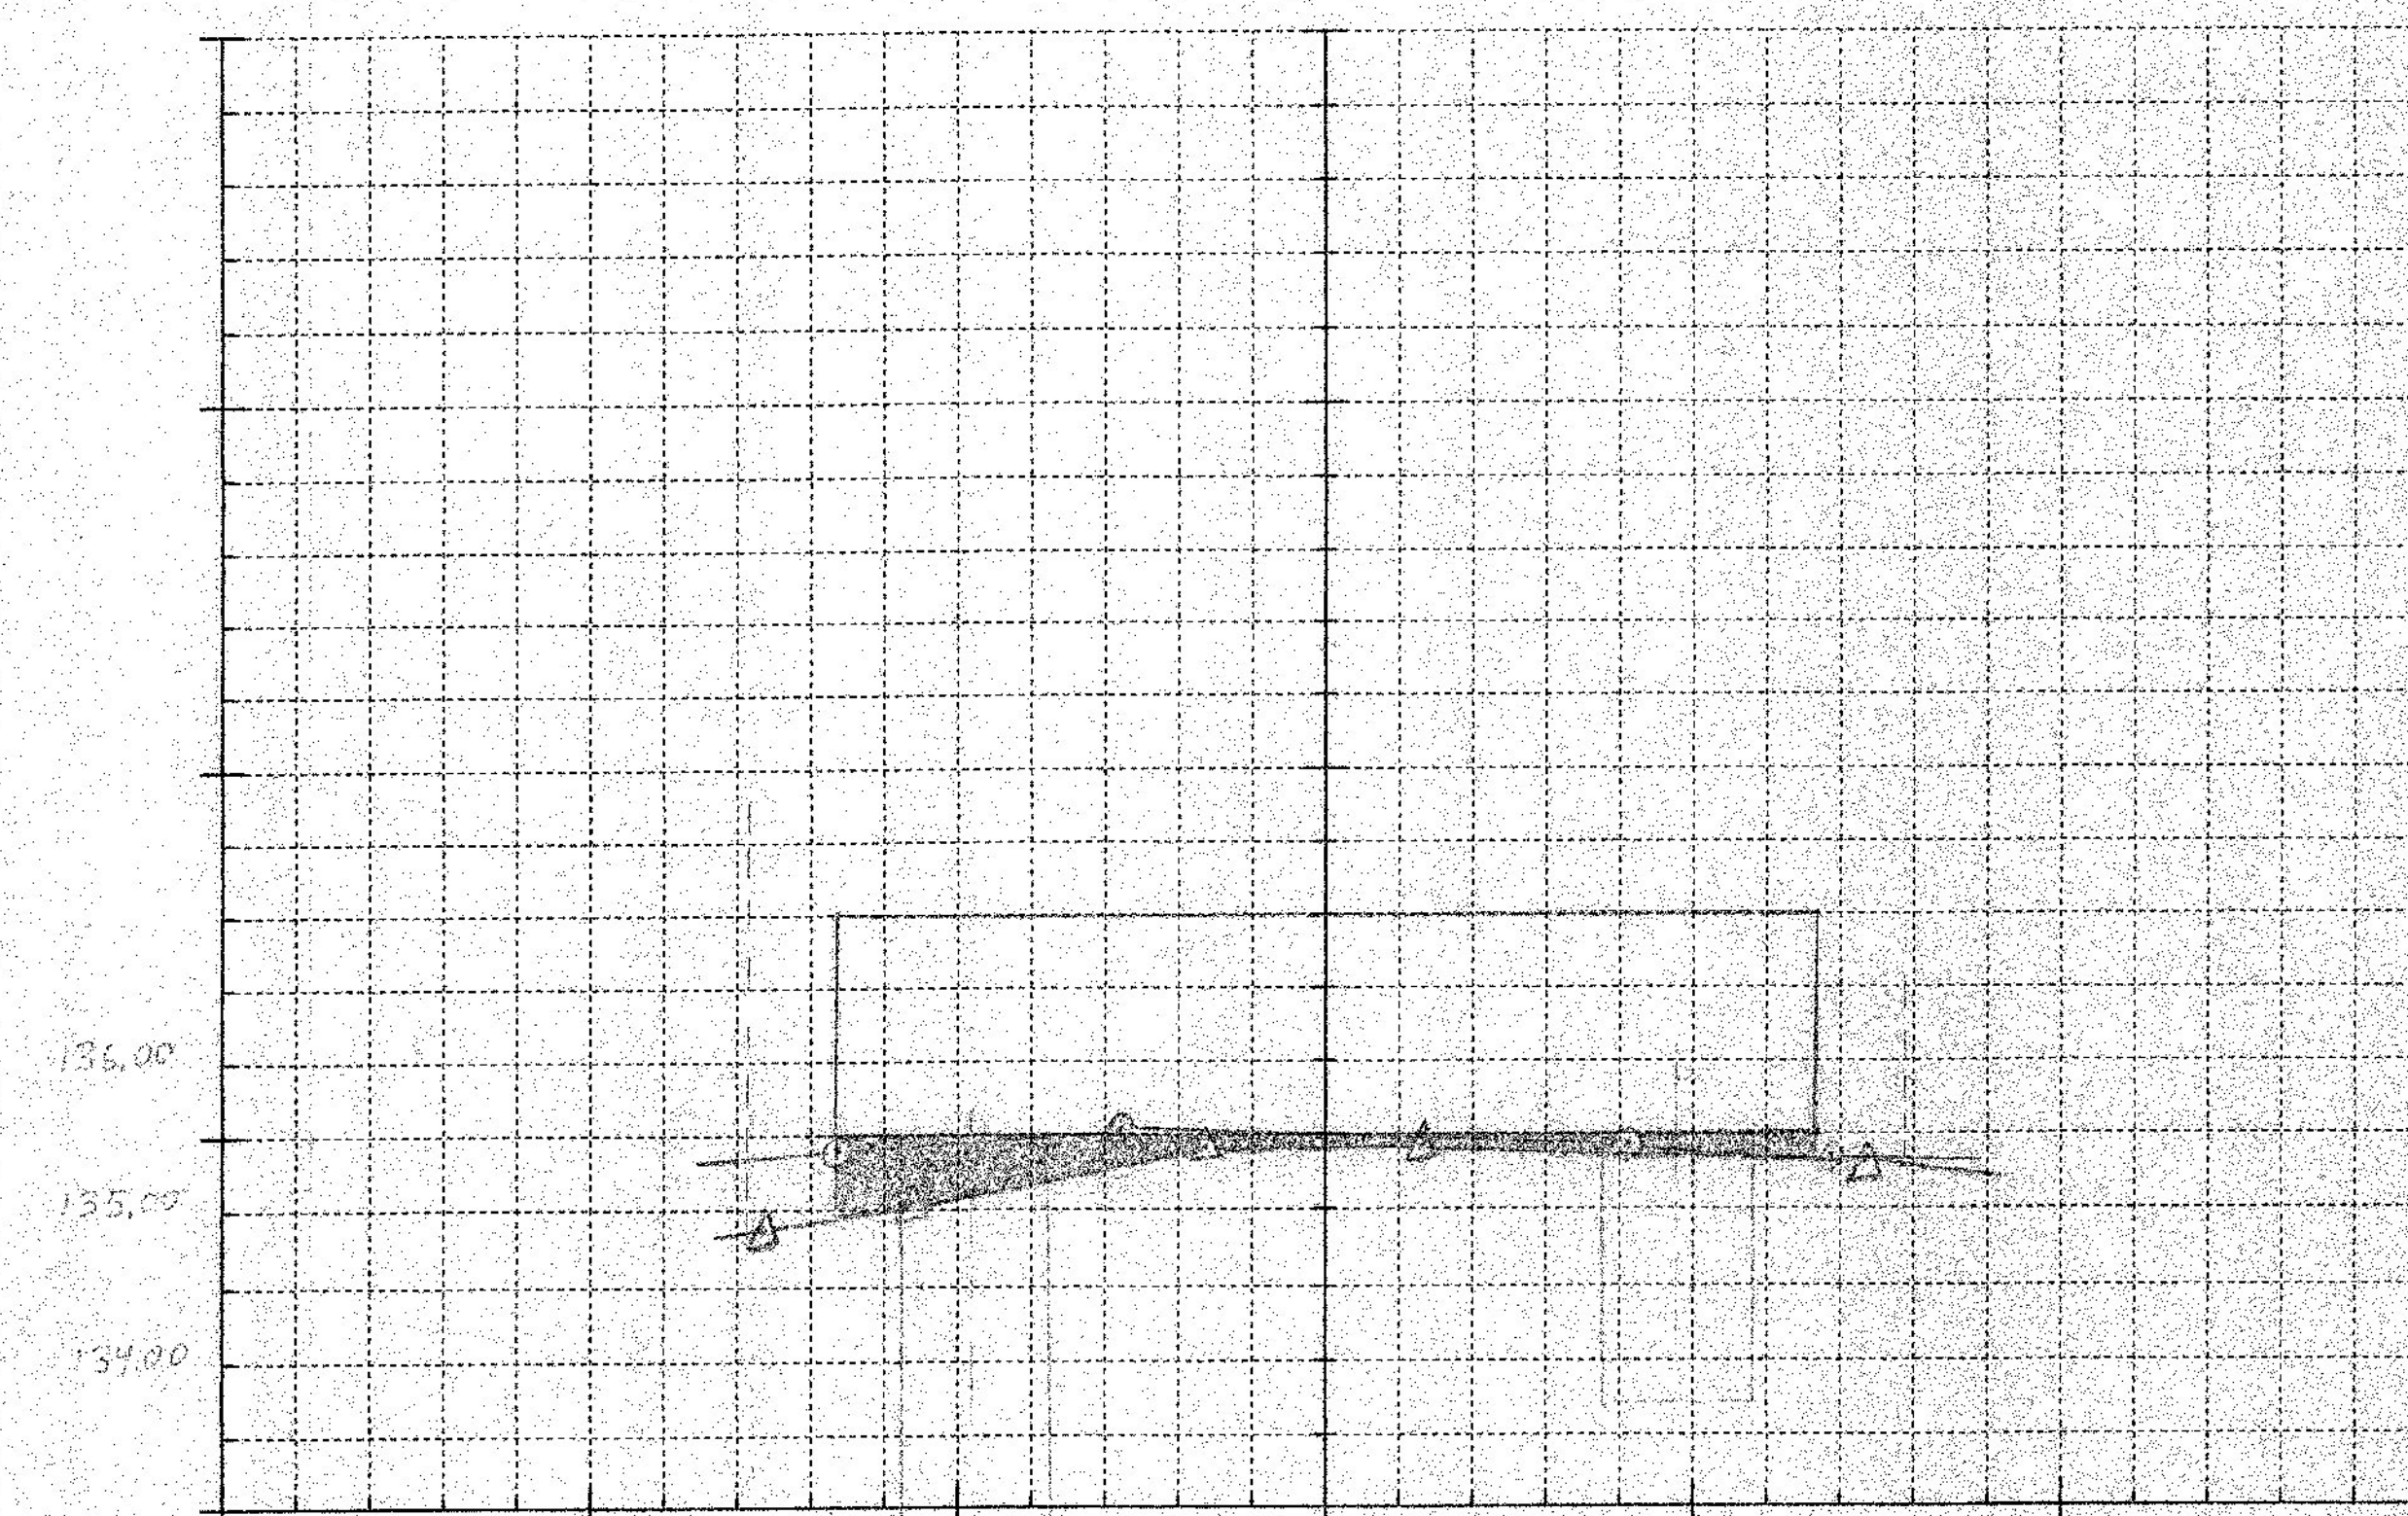

2.000 RT

Checked by: [Signature]
Checked by: [Signature]

- Original (Survey points in Survey File)
- △ Field (Gregg Field Book, May 31, 2012)
- ▨ Substituting



PROJECT:	PROJECT NO.:
DESIGN FILE NAME:	PLAT DATE:
IPARM FILE NAME:	MAINLINE ROADWAY SECTIONS
SHEET: OF	