
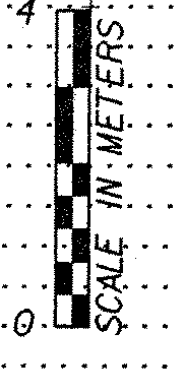


DATUM	
VERTICAL	NGVD 1929
HORIZONTAL	N/A

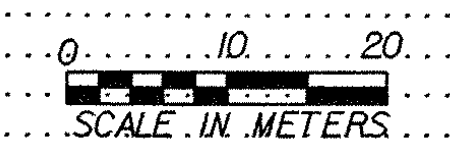

PROFILE	PROJECT:	BERKSHIRE	PROJECT NO.:	BRF-RS 0283(7)
	DESIGN FILE NAME:	/usr5/j9145620/02837bdr.dgn		
	IPARM FILE NAME:	PROJ1	PLOT DATE:	18-FEB-2000
	SURVEYED BY:		SURVEY DATE:	
	SQUAD LEADER:		DRAWN BY:	C. MABY
			SHEET:	22 OF 140