


REMOVE EXISTING LOOSE ORGANIC MATERIAL AND REPLACE WITH COMPACTED GRANULAR BORROW. SEPARATE GRANULAR BORROW FROM SUBSOIL WITH GEOTEXTILE MATERIAL. SEE CROSS SECTIONS FOR DETAILS.

| | |
|--------------|-----------|
| DATUM | |
| VERTICAL | NGVD 1929 |
| HORIZONTAL | N/A |

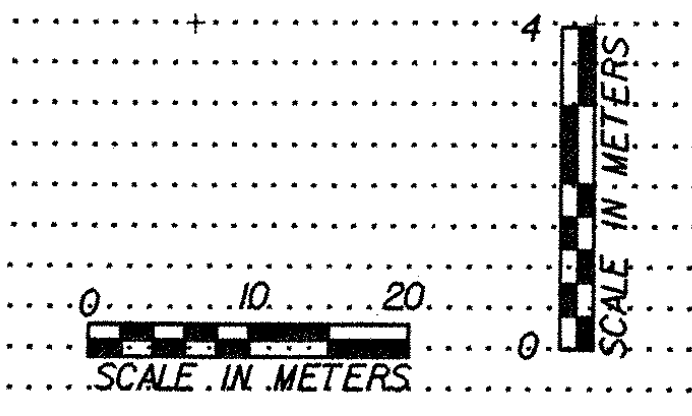

| | | | | |
|----------------|-------------------|-----------------------------|--------------|------------------|
| PROFILE | PROJECT: | BERKSHIRE | PROJECT NO.: | BRF-RS 0283(7) |
| | DESIGN FILE NAME: | /usr5/j9145620/02837bdr.dgn | | |
| | IPARM FILE NAME: | PRO2.I | PLOT DATE: | 16-FEB-2000 |
| | SURVEYED BY: | | SURVEY DATE: | |
| SQUAD LEADER: | | DRAWN BY: | C. MABY | SHEET: 23 OF 140 |