


<b>DATUM</b>	
VERTICAL	NGVD 1929
HORIZONTAL	N/A

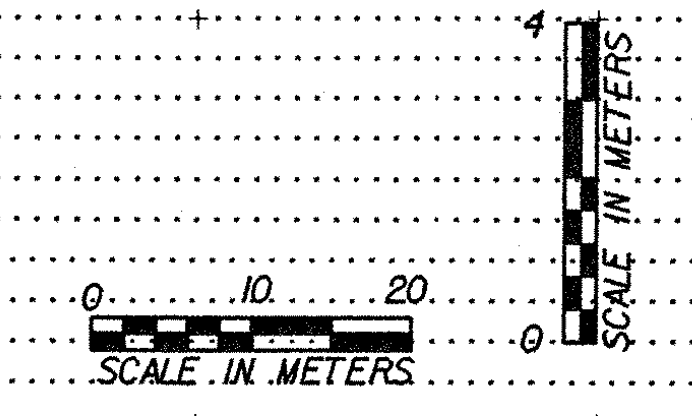

<b>PROFILE</b>	PROJECT:	BERKSHIRE	PROJECT NO.:	BRF-RS 0283(7)
	DESIGN FILE NAME:	p:\J9145620\02837bdr.dgn		
	IPARM FILE NAME:	PRO3.I	PLOT DATE:	16-FEB-2000
	SURVEYED BY:		SURVEY DATE:	
SQUAD LEADER:		DRAWN BY:	C. MABY	
		SHEET:	24 OF 140	