
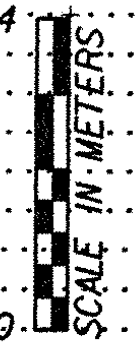


DATUM
 VERTICAL NGVD 1929
 HORIZONTAL N/A

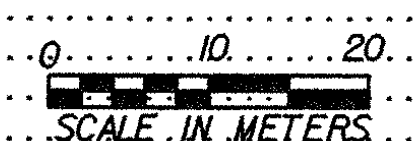

PROFILE	PROJECT: BERKSHIRE	PROJECT NO.: BRF-RS 0283(7)
	DESIGN FILE NAME: p:\j9145620\02837bdr.dgn	PLOT DATE: 16-FEB-2000
	IPARM FILE NAME: RPRTPROF.I	SURVEY DATE:
	SURVEYED BY:	DRAWN BY: C. MABY
SQUAD LEADER:	SHEET: 25 OF 140	

78f184/zf184PF4