


PLAN
SCALE: 1/100

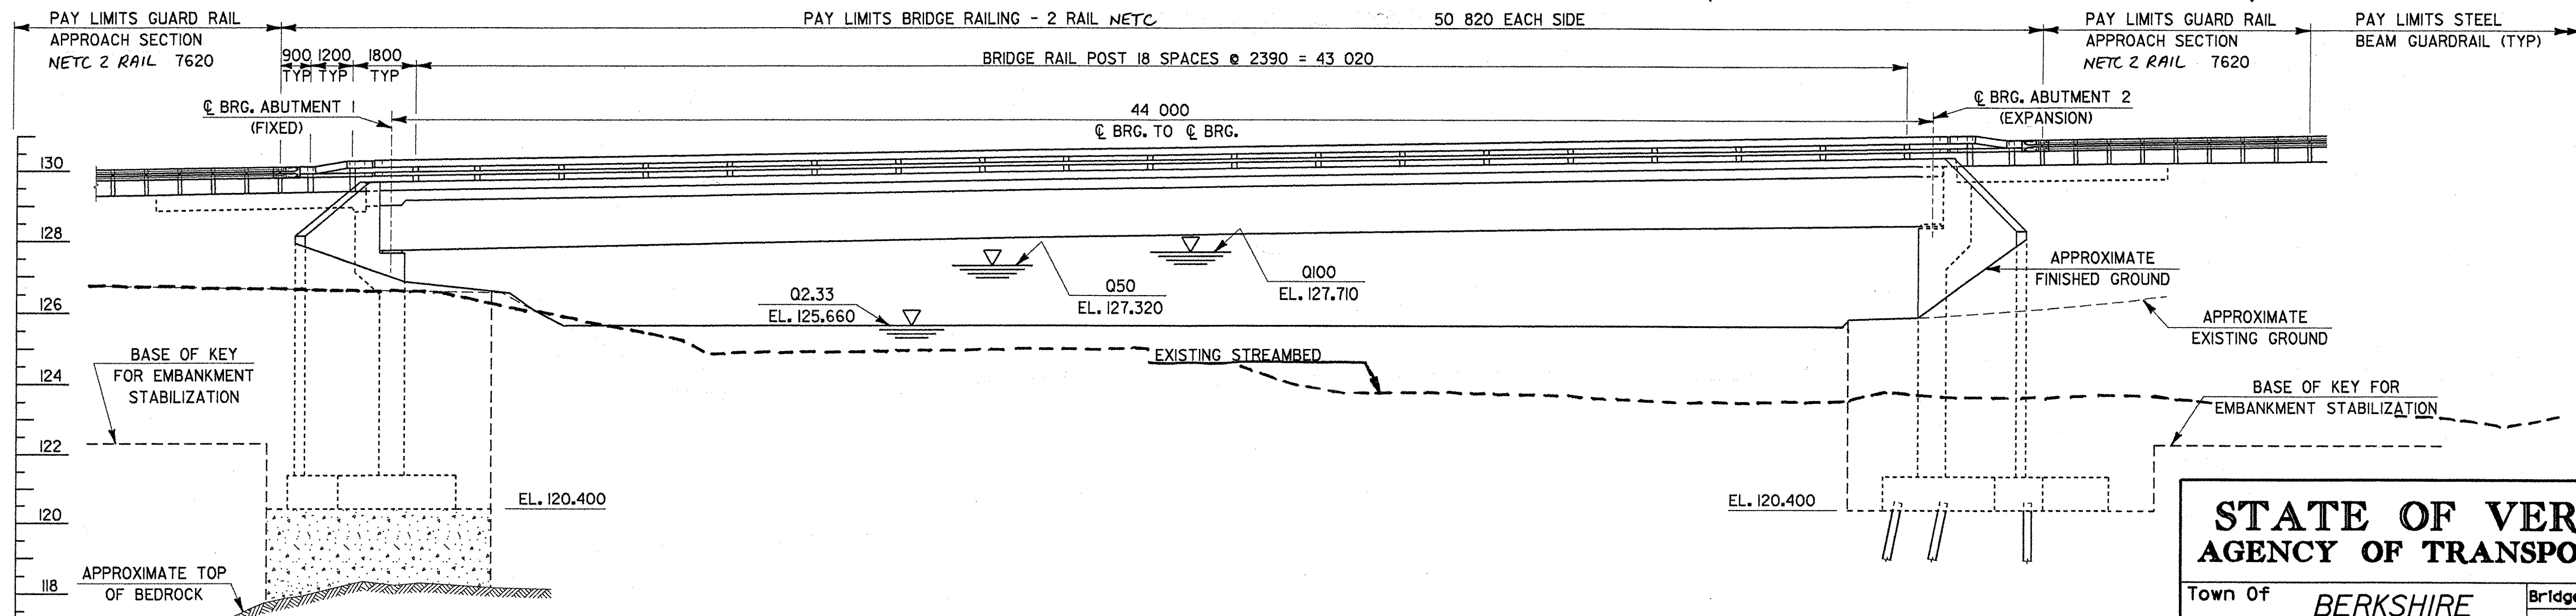

ELEVATION
SCALE: 1/100

STATE OF VERMONT AGENCY OF TRANSPORTATION	
Town Of BERKSHIRE	Bridge No. 26
Highway No. VT.ROUTE 118	Log Sta. Surv. Sta.
VT.ROUTE 118 OVER TROUT RIVER PLAN AND ELEVATION	
Designed By S.JOHNSON	Drawn By S.DELIA
Checked By S.JOHNSON	Date 02/00 Bridge Design Supervisor Date
PROJECT BERKSHIRE	PROJECT NO. BRF-RS 0283(7)
I.G.C. Info. y:\1914562\z\184gpl.dgn	I\PARM\z\184gpl
Bridge Sheet No. BR11	Sheet 50 of 140