

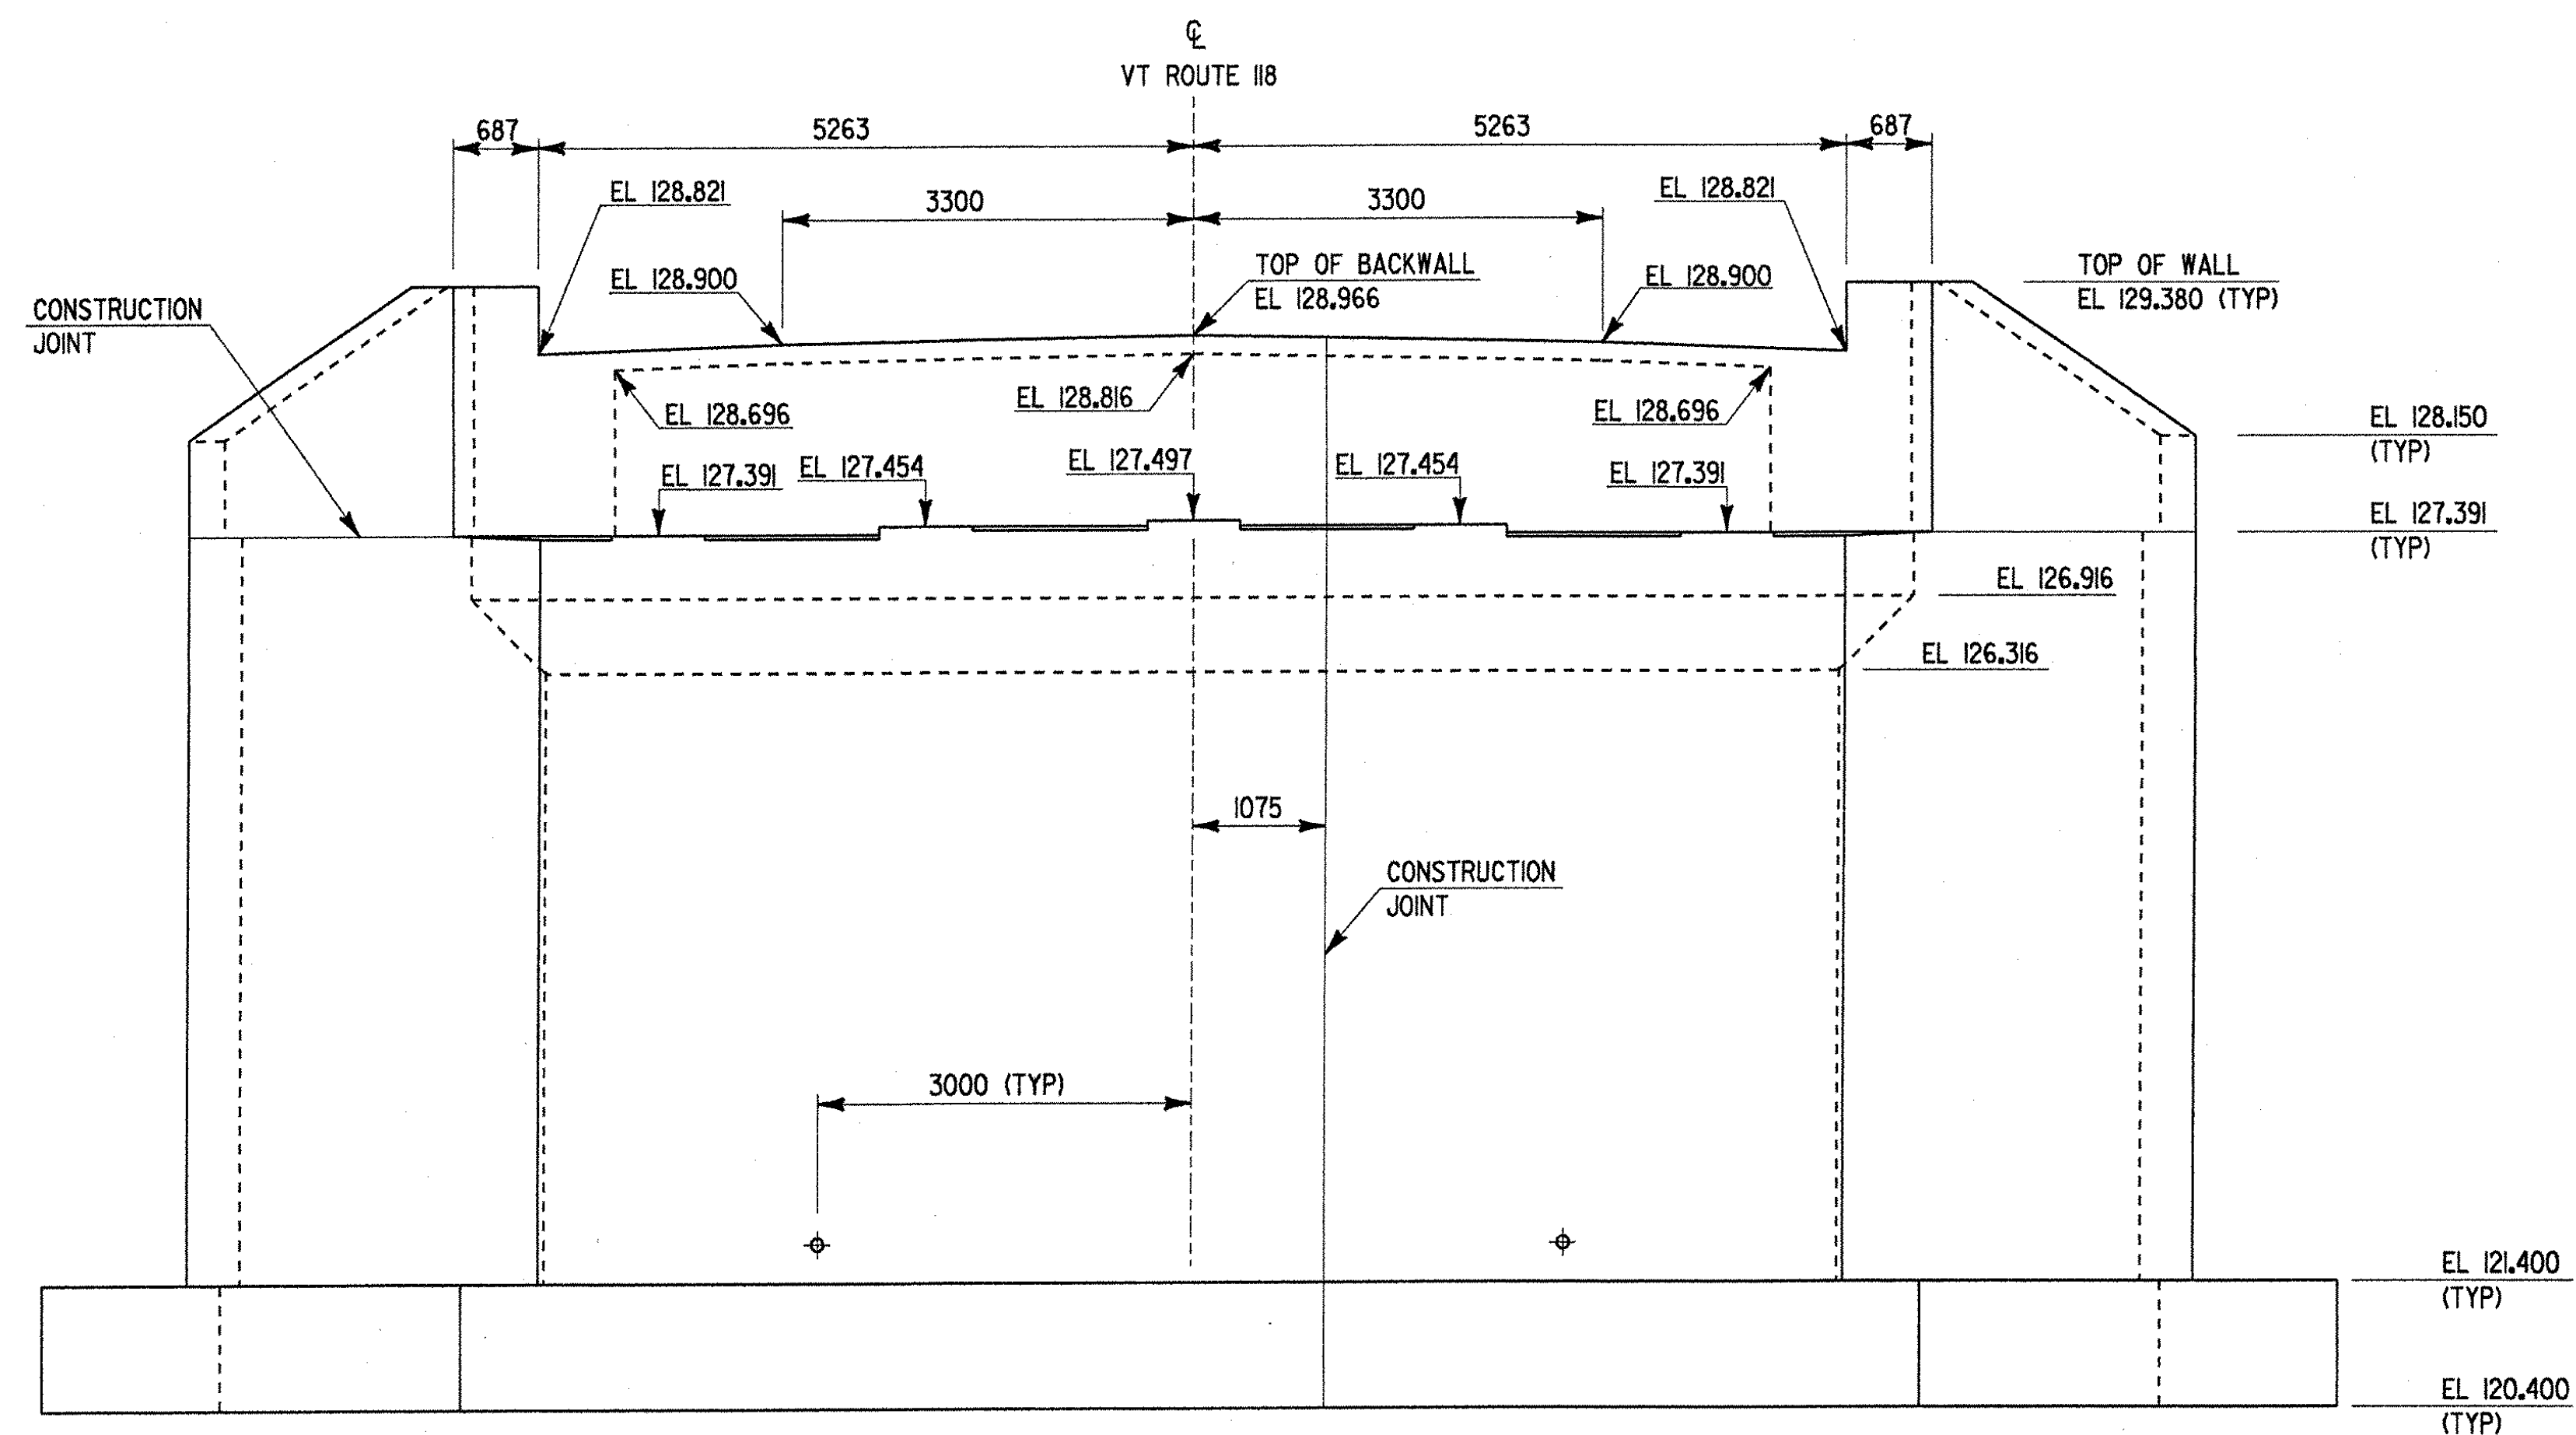
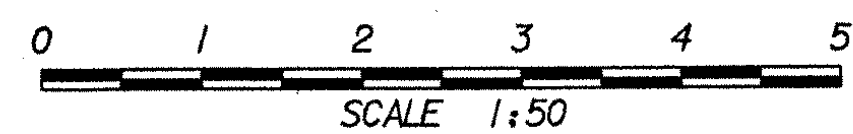



ABUTMENT NO. 1 PLAN

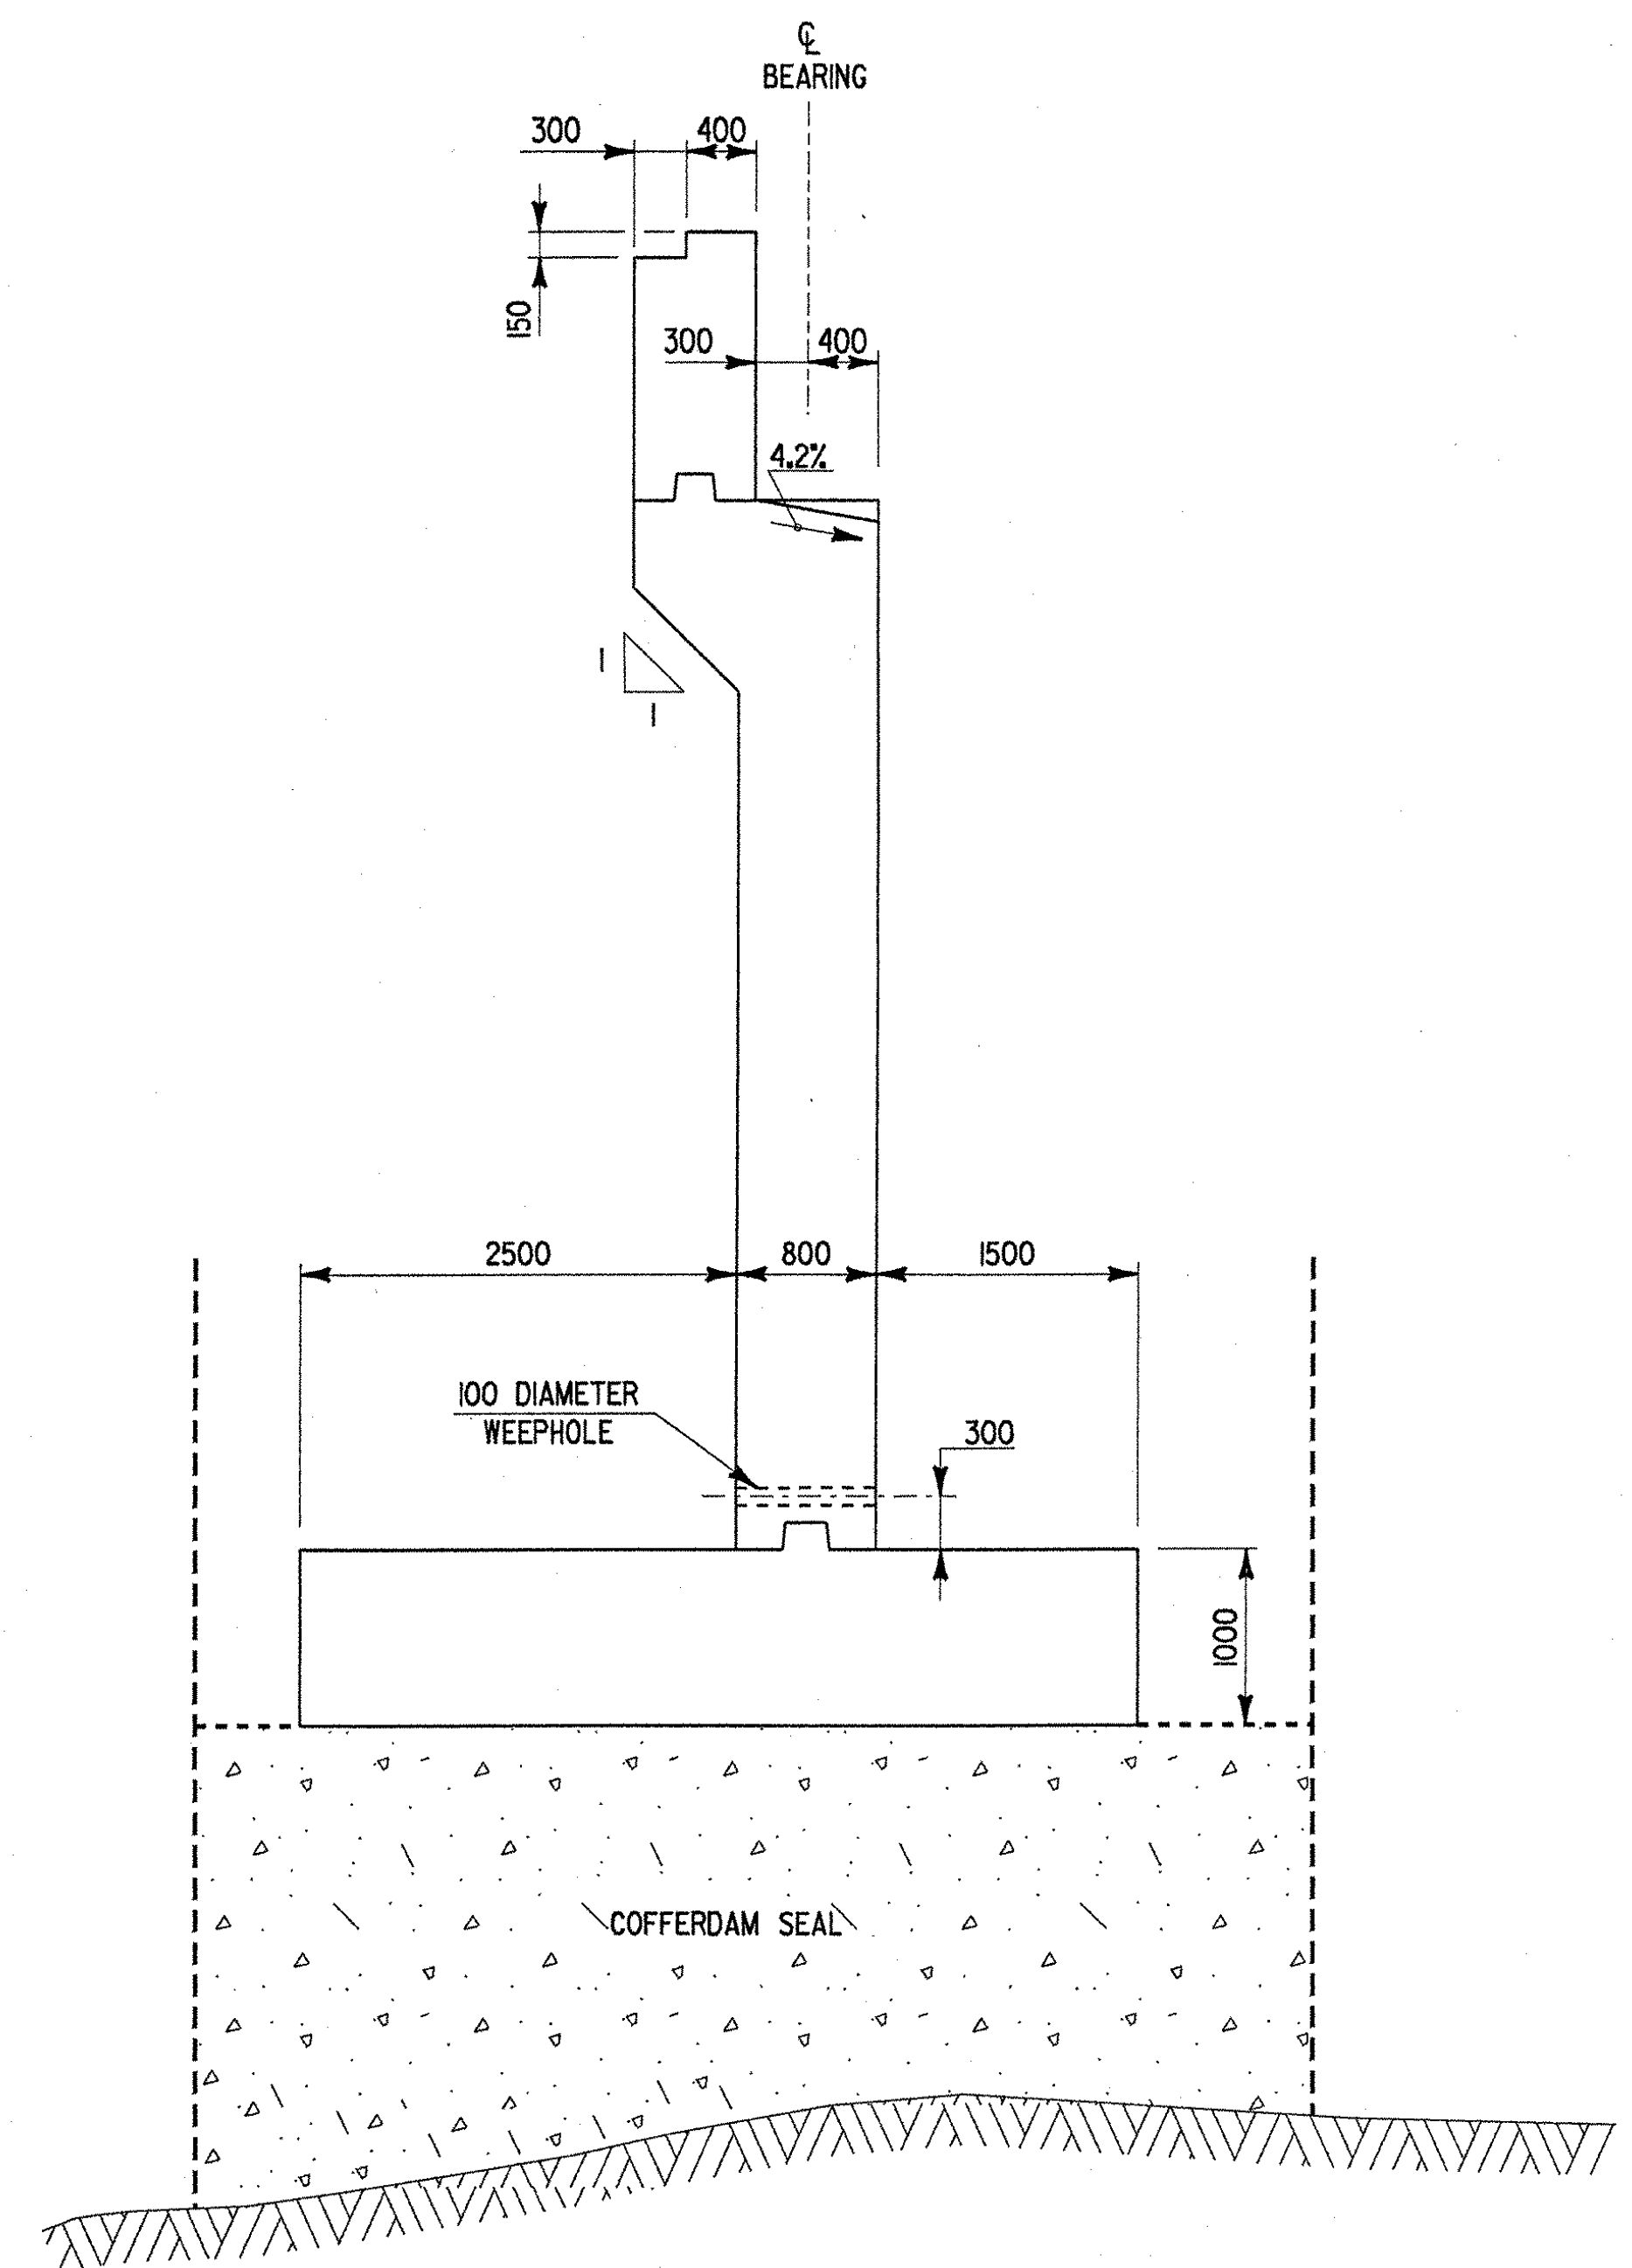

ABUTMENT NO. 1 ELEVATION

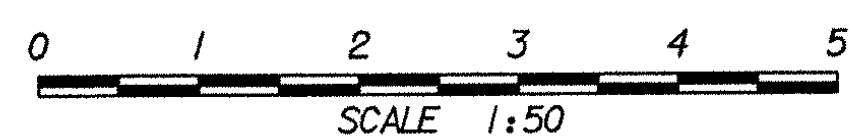

ABUTMENT NO. 1 TYPICAL SECTION

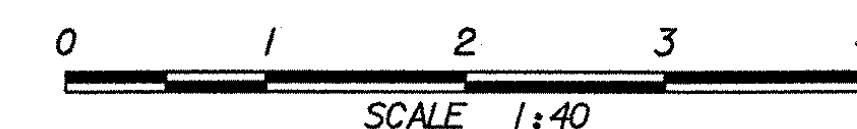

**STATE OF VERMONT
AGENCY OF TRANSPORTATION**

| | | | |
|---|---------------|--------------------------|----------------|
| Town Of | BERKSHIRE | Bridge No. | 26 |
| Highway No. | VT. ROUTE 118 | Log Sta. | |
| VT. ROUTE 118 OVER TROUT RIVER ABUTMENT NO. 1 PLAN AND ELEVATION | | | |
| Designed By | S. JOHNSON | Drawn By | S. DELIA |
| Checked By | S. JOHNSON | Date | 02/00 |
| | | Bridge Design Supervisor | Date |
| PROJECT | BERKSHIRE | PROJECT NO. | BRF-RS 0283(7) |
| I.G.C. Info. y:\914562\zf184aml.dgn | | IPARM:zf184aml.j | |
| Bridge Sheet No. | BR22 | Sheet | 61 of 140 |