


STA. 10+030
MATCH
EXISTING
PAVEMENT

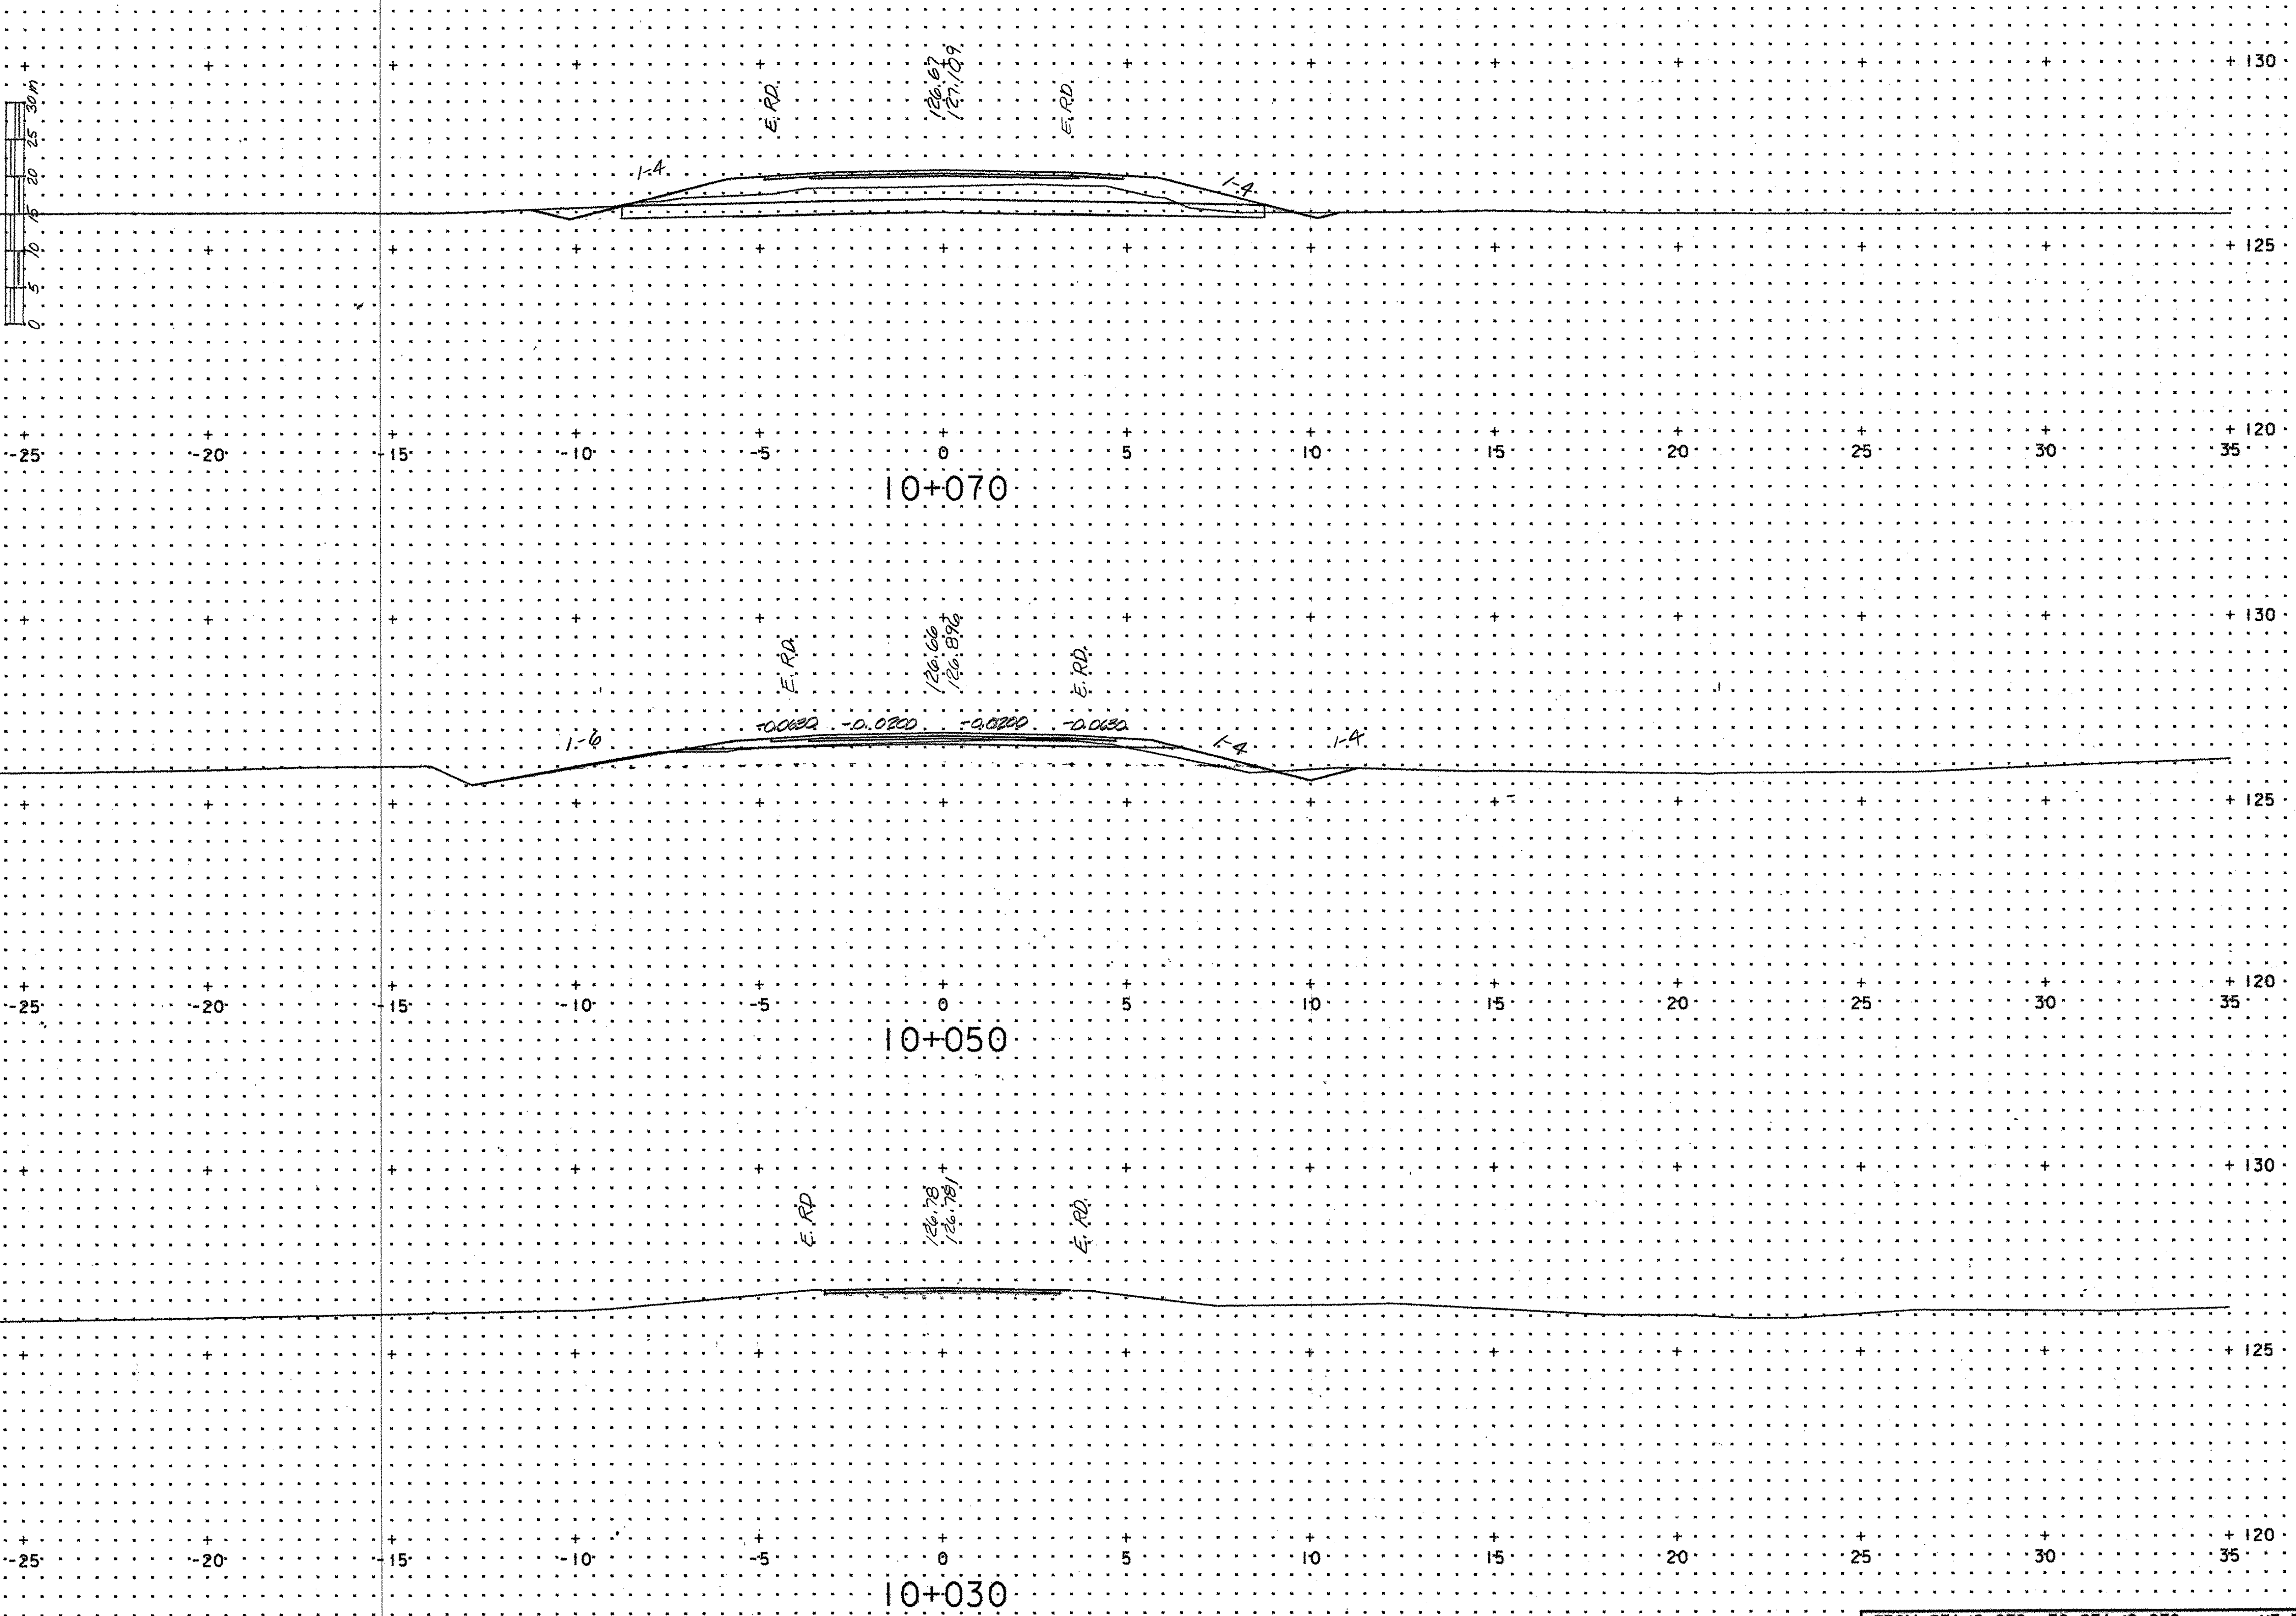

User: 5/1945520/028317.dgn

SCALE 1m

FROM STA. 10+030 TO STA. 10+070 VT. RTE. 118
 PROJECT NAME: VERMONT ROUTE 118 OVER TROUT RIVER
 PROJECT NO. BRS 0283(7)
 PLOTTED BY: CJM 10/28/96 CHECKED BY: JAV 10/29/96
 SHEET 68 OF 140 SHEETS

78f184/zf184x01