



10+370

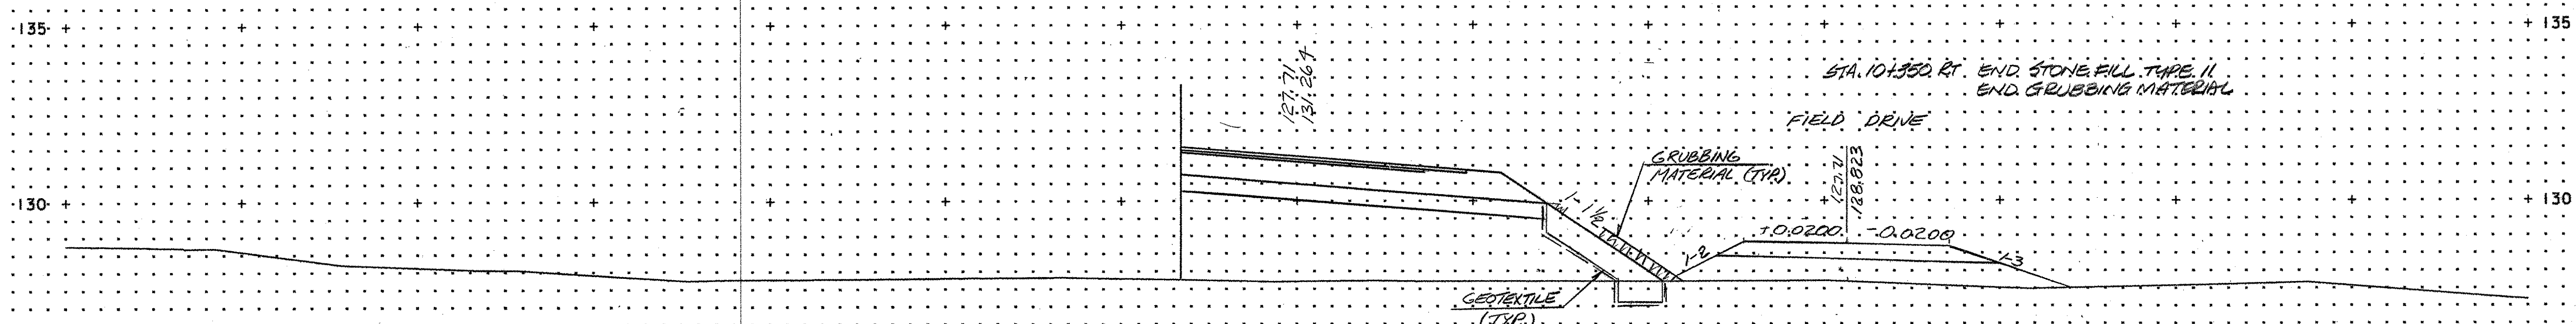

10+350

STA. 10+340 LT. END STONE FILL TYPE II
END GRUBBING MATERIAL

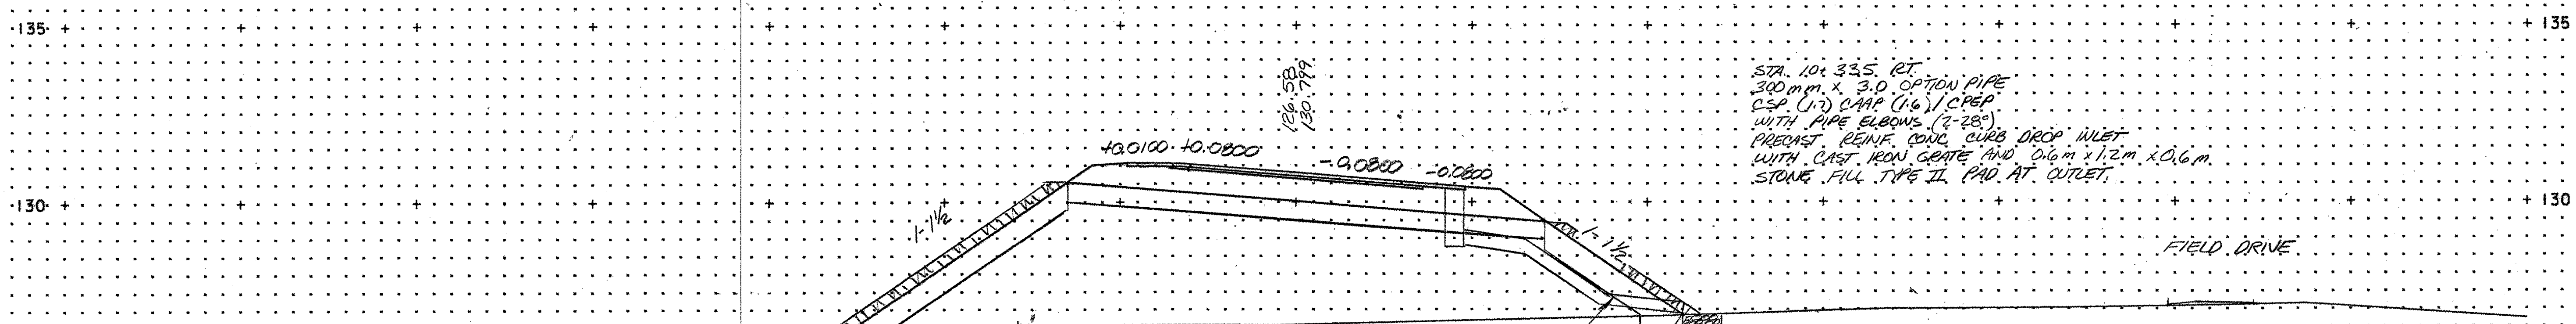

10+330

STA. 10+335 RT.
300mm x 3.0' O.P.TON PIPE
C&P (1.7) CAP (1.6) / C&P
WITH PIPE ELBOWS (2'-28")
PRECAST REINF. CONC. CURB DROP INLET
WITH CAST IRON GRATE AND 0.6m x 1.2m x 0.6m
STONE FILL TYPE II PAD AT OUTLET.

FIELD DRIVE

FROM STA. 10+330 TO STA. 10+370 VT. RTE. 118
PROJECT NAME: VERMONT ROUTE 118 OVER TROUT RIVER
PROJECT NO. BRS 028317
PLOTTED BY: CJM 10/28/96 CHECKED BY: JAV 10/29/96
SHEET 73 OF 140 SHEETS

SCALE 1" = 1m

781184/z1184x06

/usr5/ps45620/028317.dgn